
46334
64695

T. 2S., R. 27E., W.M.

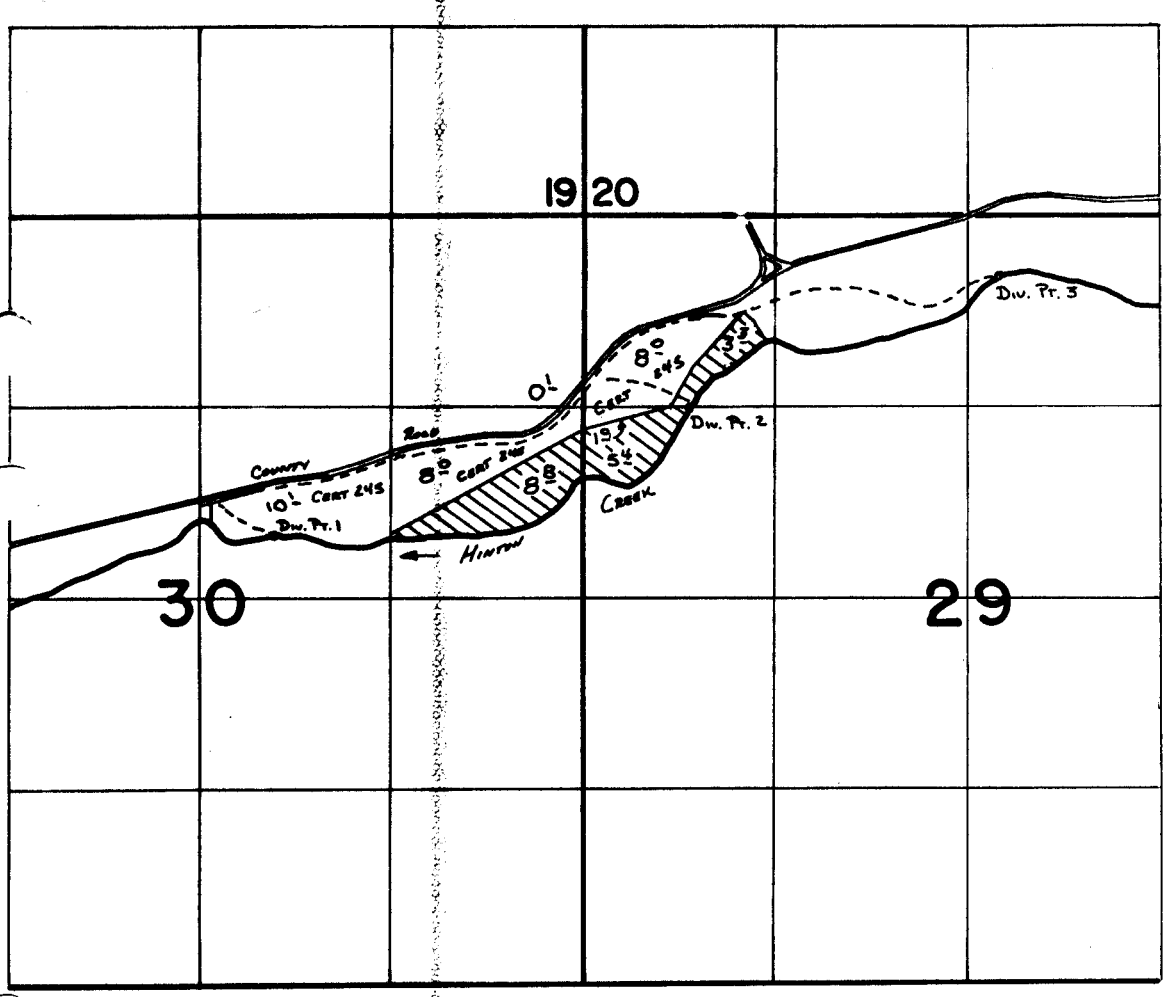

Div. Pt. 1 Located 440'N. & 510'E. From Center Cor. Sec. 30
Div. Pt. 2 Located 1320'S. & 730'E. From NW Cor. Sec. 29
Div. Pt. 3 Located 420'S. & 210'E. From N¼ Cor. Sec. 29

SCALE: 1" = 1320'

FINAL PROOF SURVEY

UNDER

Application No. 60970 Permit No. 46334

IN NAME OF

RAYMOND FRENCH

Surveyed June 25, 1984, by V.L. Church

472-65