


T. 37 S., R. 6 W., W.M.

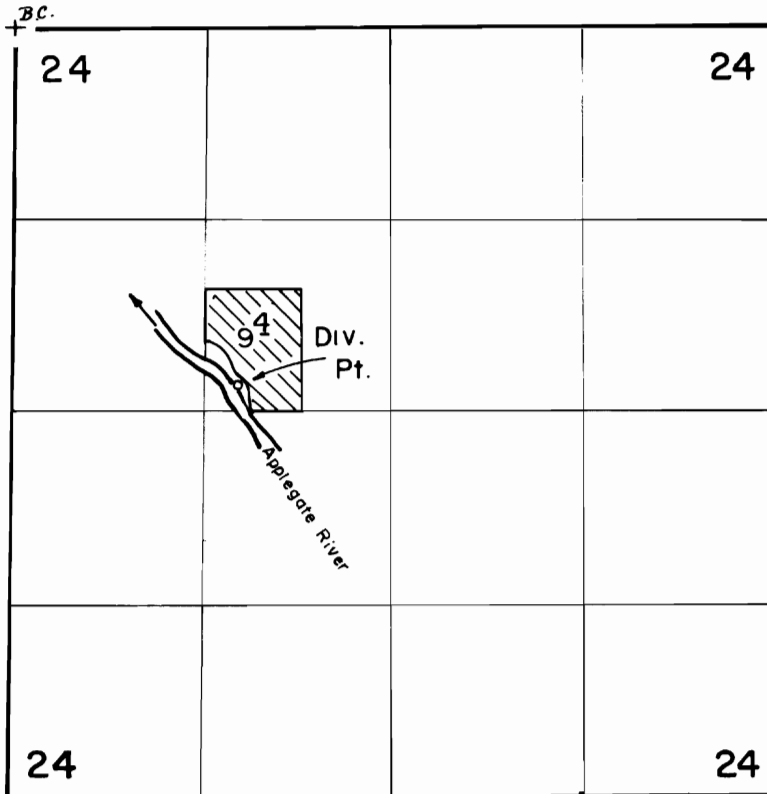

SCALE:
1" = 1320'

Div. Pt. - 170' N., 1050' W.,
from C. cor., Sec. 24

FINAL PROOF SURVEY

UNDER

TRANSFER NO. 4849

Application No. **62351** Permit No. **46089**
IN NAME OF

HARRY LA CHANCE, JR.

Surveyed **JUL. 29. 1986**, by **B. S. JAMES**