


T. 4 N. R. 28 E. W.M.

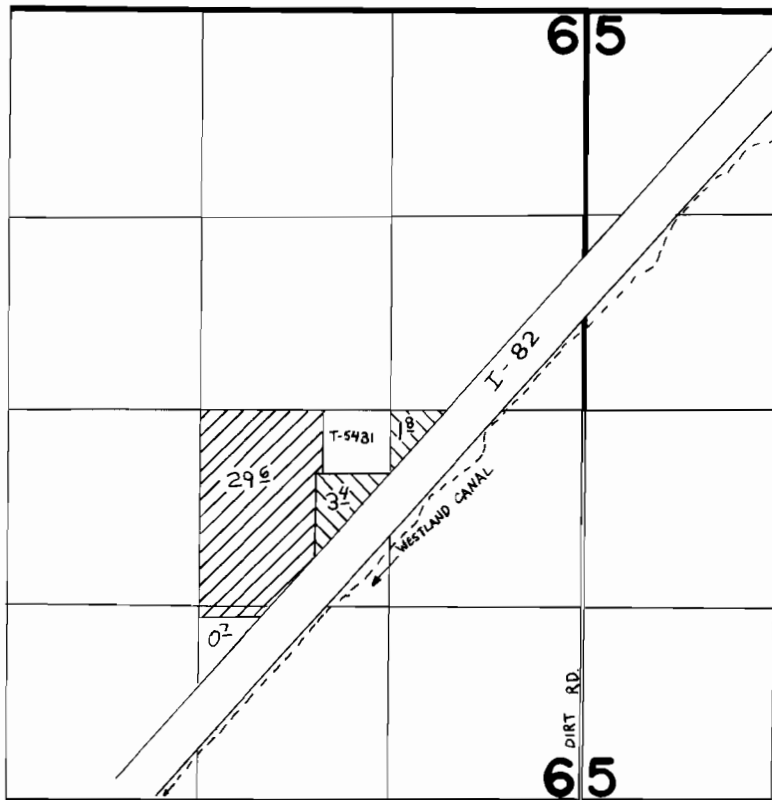

Scale 1" = 1320'



 PER. 47621

 T-5676

FINAL PROOF SURVEY UNDER


TRANSFER 5676

Application No. 6.4.91.7... Permit No. 4.7.621.....
IN NAME OF

MATTHEW P. DOHERTY

Surveyed March 4, 1987, by V. Church.....

T. 3 N. R. 29 E. W.M.

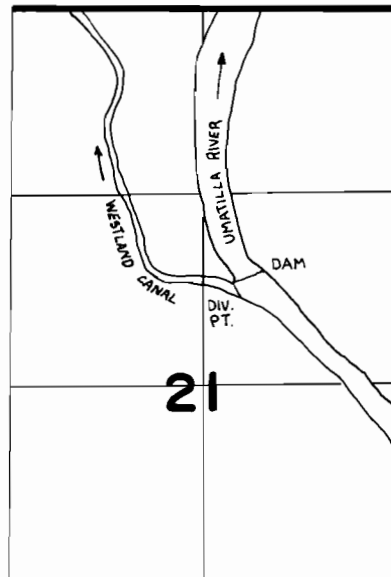

DIV. PT. LOC. N. 76° 45' 56" E 2913.19' FROM
W. 1/4 COR. SEC. 21