


T. 30 S., R. 6 W., W. M.

SECTION 26

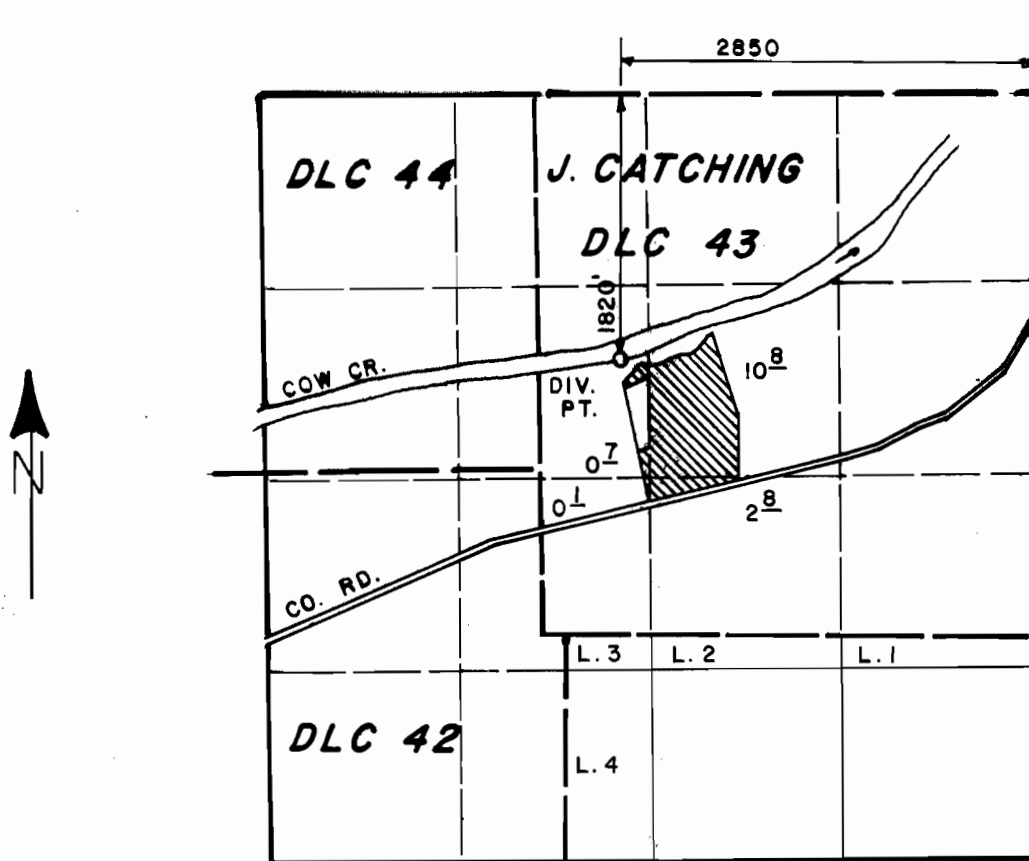

SCALE: 4" = 1 MILE

FINAL PROOF SURVEY
UNDER

Application No. 68018... Permit No. 48462...
IN NAME OF

THOMAS H. IRELAND

Surveyed JUNE 23, 1988, by J. M. SCHMORDE