


T. 2 N., R. 48 E., W. M.

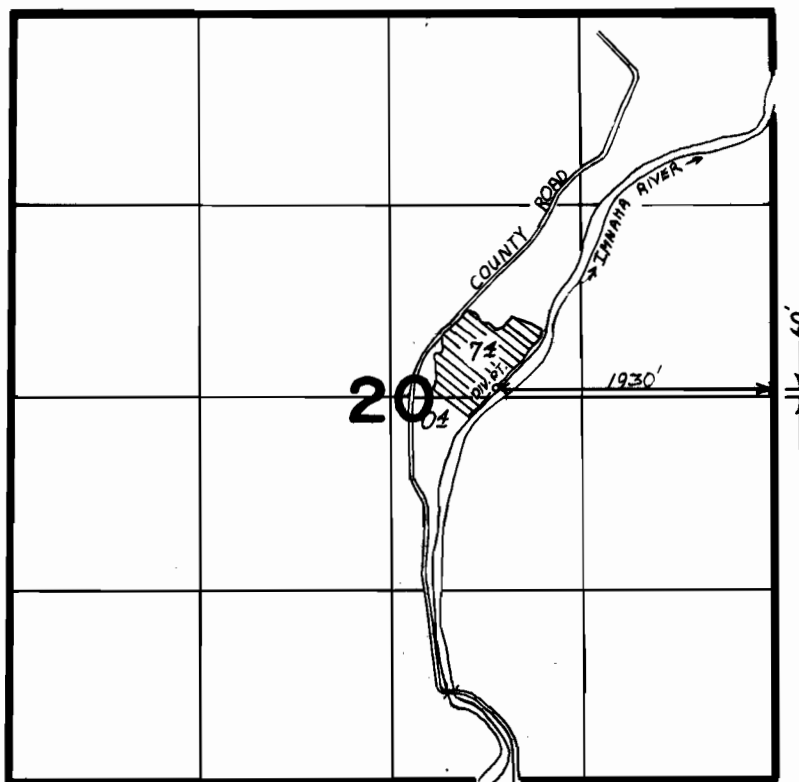

SCALE: 1"=1320'



FINAL PROOF SURVEY
UNDER

Application No. 68021... Permit No. 48463....

IN NAME OF

DONALD MAXWELL

Surveyed Aug. 7..... 1985., by V. L. CHURCH.....