

FINAL PROOF SURVEY MAP

IN THE NAME OF : J. C. & MARGARET C. TURNER



S19, T26S, R4W, WM

LOT 33 EAGLE POINT ESTATES
APPLICATION 69207 PERMIT 5019



THE POINT OF DIVERSION IS LOCATED 520 FEET NORTH
AND 390 FEET EAST FROM THE WEST 1/4 CORNER OF
SECTION 19.

1" = 200'

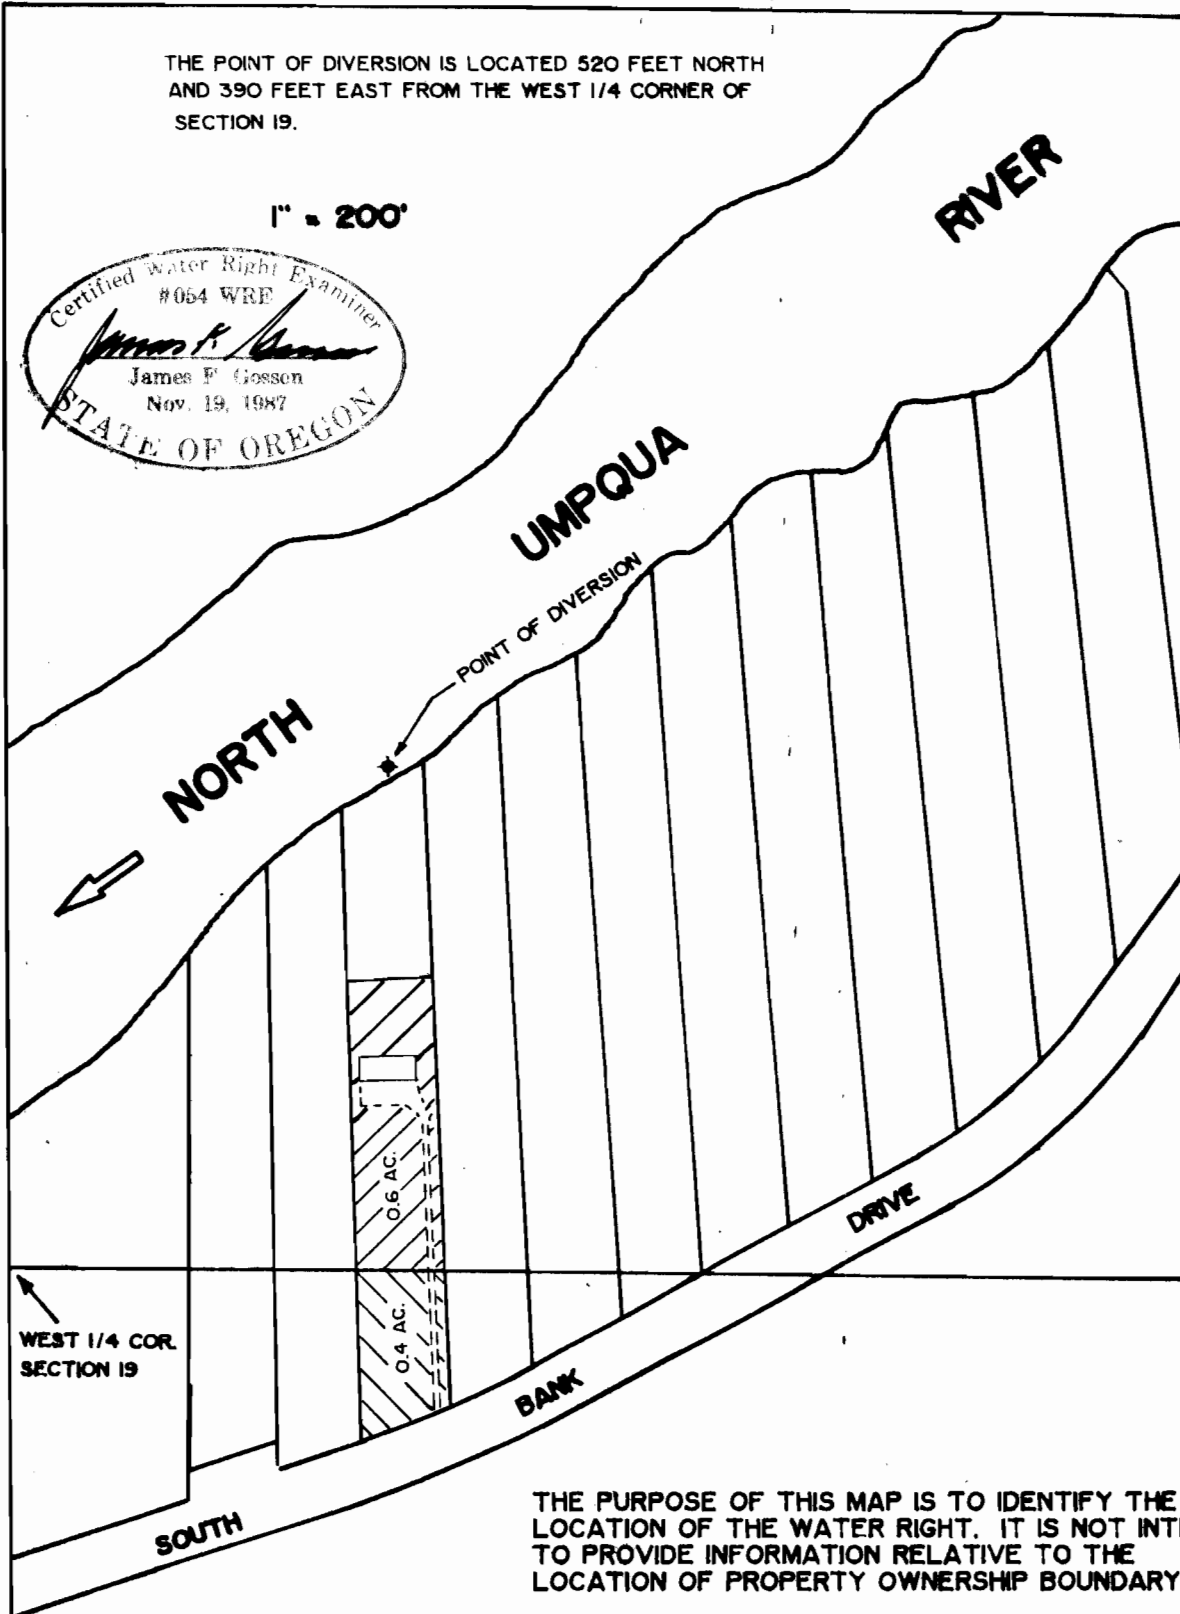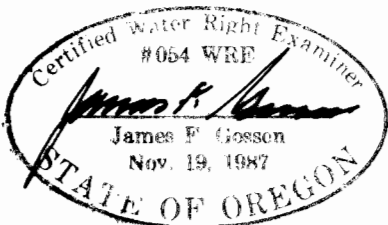

THE PURPOSE OF THIS MAP IS TO IDENTIFY THE
LOCATION OF THE WATER RIGHT. IT IS NOT INTENDED
TO PROVIDE INFORMATION RELATIVE TO THE
LOCATION OF PROPERTY OWNERSHIP BOUNDARY LINES.