


S.E. 1/4, N.E. 1/4 SECTION 18, TOWNSHIP 26 SOUTH, RANGE 4 WEST, W.M.

LOT 34 WHISTLERS PARK ESTATES

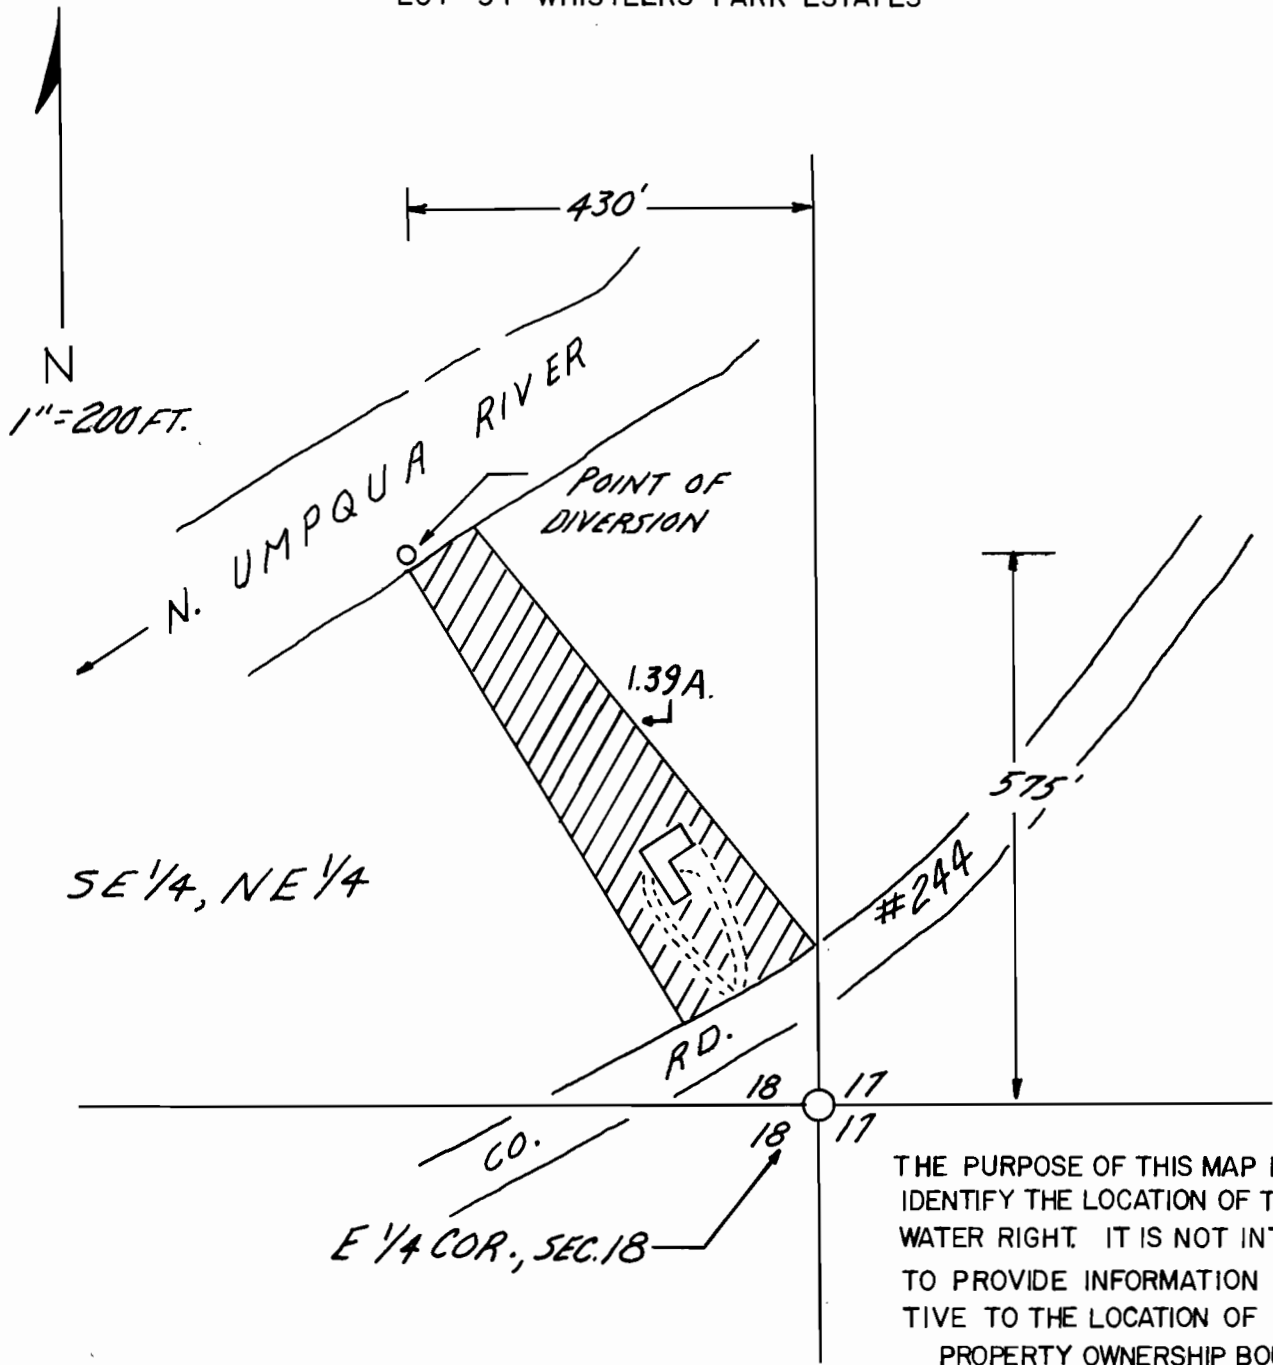

THE PURPOSE OF THIS MAP IS TO IDENTIFY THE LOCATION OF THE WATER RIGHT. IT IS NOT INTENDED TO PROVIDE INFORMATION RELATIVE TO THE LOCATION OF PROPERTY OWNERSHIP BOUNDARY LINES.

**FINAL PROOF SURVEY**  
UNDER

Application No. 69224 Permit No. 50131  
IN NAME OF

**BOYLES, EVELYN M.**

Surveyed 2-27 1988, by J. F. GOSSON

