

FINAL PROOF SURVEY MAP



IN THE NAME OF : JOHN T. MINER

S586, T26S, R6W, W.M.

APPLICATION 69276 PERMIT 50152



1 INCH = 400 FEET

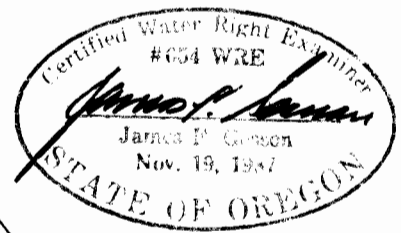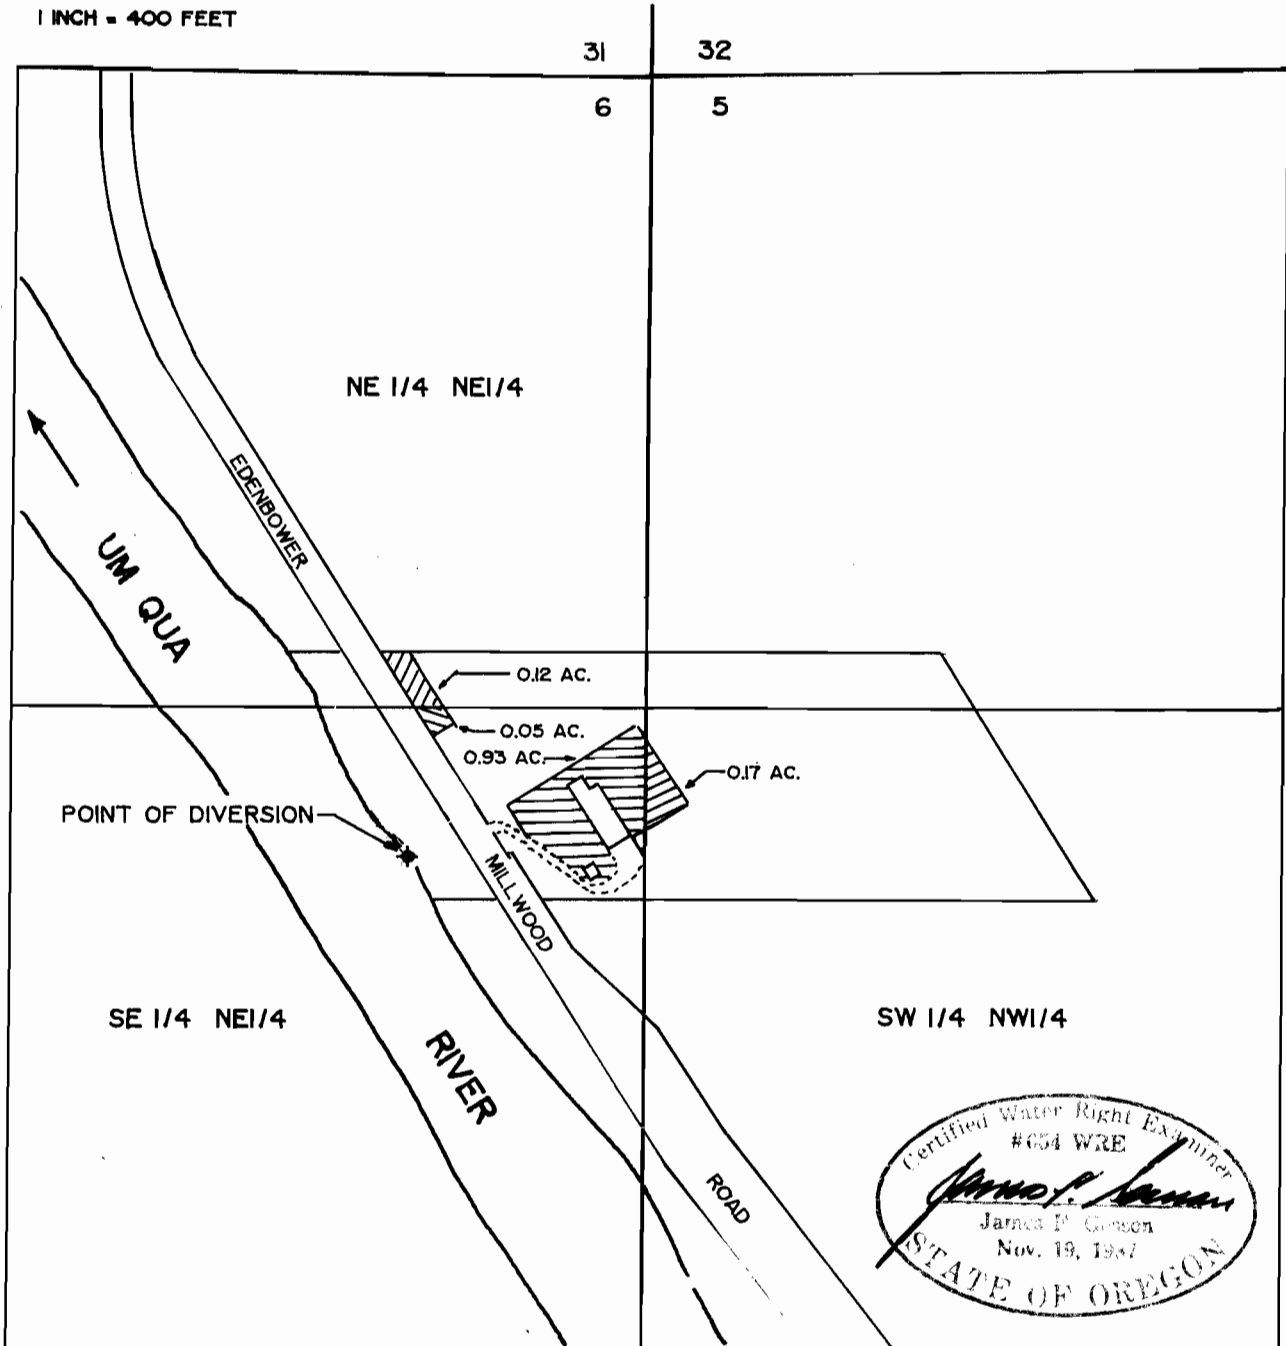

THE POINT OF DIVERSION IS 1630 FEET SOUTH AND 500 FEET WEST FROM THE NORTHEAST CORNER OF SECTION 6, BEING WITHIN THE SE1/4, NE1/4 OF SECTION 6, TOWNSHIP 26 SOUTH, RANGE 6 WEST, W.M.

THE PURPOSE OF THIS MAP IS TO IDENTIFY THE LOCATION OF THE WATER RIGHT. IT IS NOT INTENDED TO PROVIDE INFORMATION RELATIVE TO THE LOCATION OF PROPERTY OWNERSHIP BOUNDARY LINES.