

FINAL PROOF SURVEY MAP


IN THE NAME OF WAYNE, MARLENE, AND MIKE LOPERA

SECTION 35, T25S, R7W, WM

APPLICATION #69283 PERMIT #50199



1 INCH = 1320 FEET

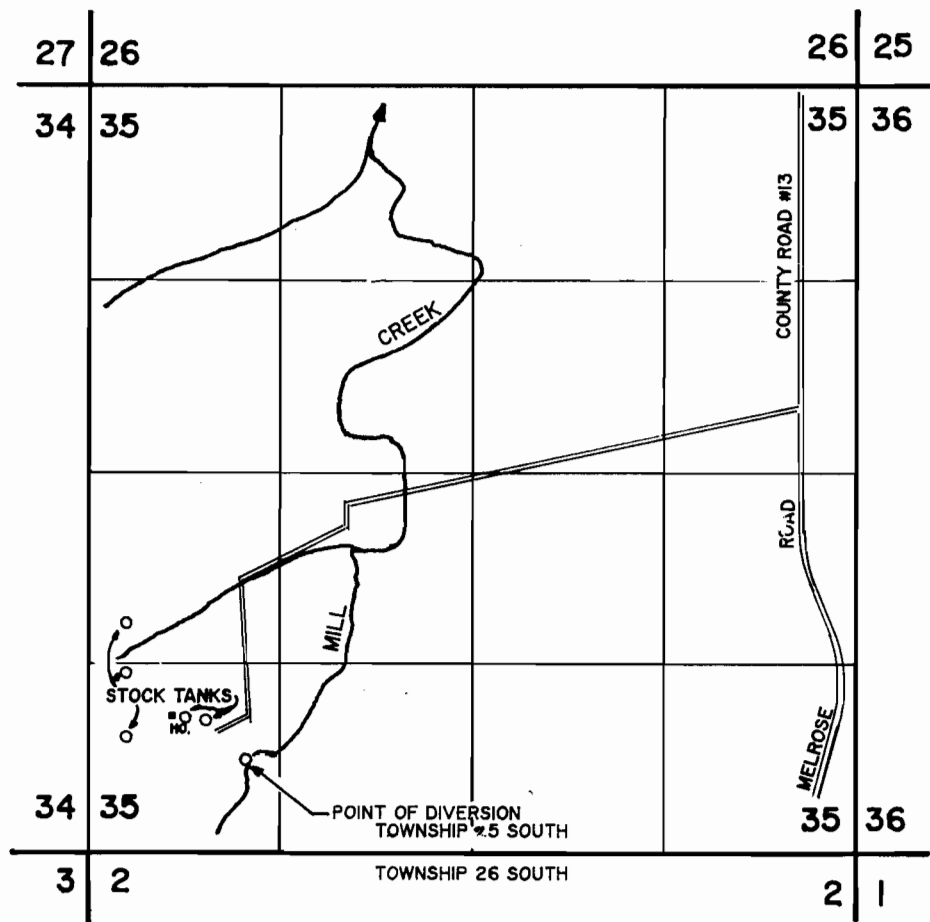

THE POINT OF DIVERSION IS LOCATED 640 FEET NORTH AND 1090 FEET EAST FROM THE SOUTHWEST CORNER OF SECTION 35.

THE PURPOSE OF THIS MAP IS TO IDENTIFY THE LOCATION OF THE WATER RIGHT. IT IS NOT INTENDED TO IDENTIFY THE LOCATION OF PROPERTY OWNERSHIP BOUNDARY LINES.

