

Point of Diversion is common to Helen K. Smith's Permit No. 50263 and Herbert R. Forbess' Permit to Appropriate Surface Water, application filed Oct. 30, 1989.



Scale: 1" = 200 ft.


FINAL PROOF SURVEY OF PERMIT TO APPROPRIATE THE PUBLIC WATERS IN THE SW 1/4 OF SECTION 13, T 26 S, R 4 W, W. M., DOUGLAS COUNTY, OREGON

Application No. 69386

Permit No. 50263

For: Helen Kathleen Smith
2771 Wild River Drive
Roseburg, Oregon 97470

By: Shaner Engineering, Inc.
P. O. Box 1430
Roseburg, Oregon 97470

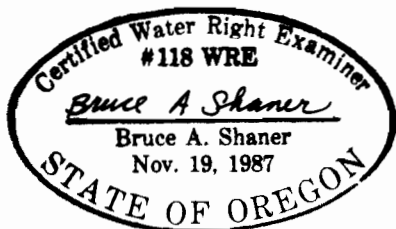

October 30, 1989