
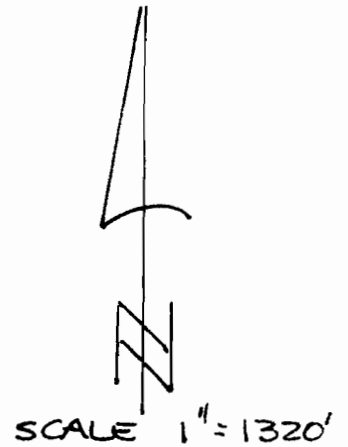


Application No. R-69414 & 69415  
Permit No. R10898 50203

**RECEIVED**  
OCT 19 1987  
WATER RESOURCES DEPT  
SALEM OREGON

T. 9 S. R. 2 E.

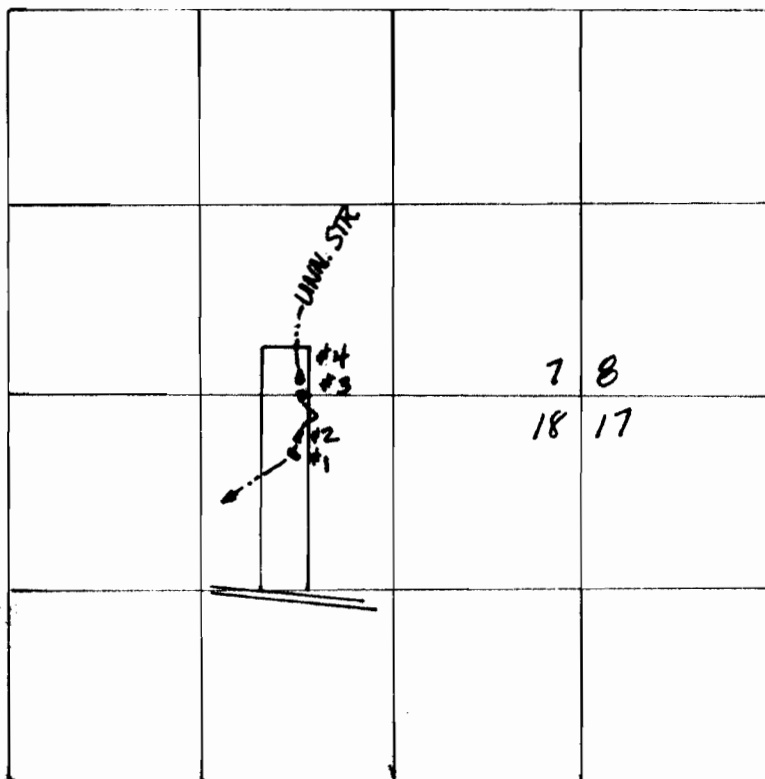

**RES. LOCATION**

- #1 390' S. 1950' W.
- #2 240' S. 1940' W.
- #3 30' S. 1930' W.
- #4 50' N. 1930' W.

ALL FROM N.E. CORNER OF  
SECTION 18 T9S R2E