
T.9S., R.2E., W.M.

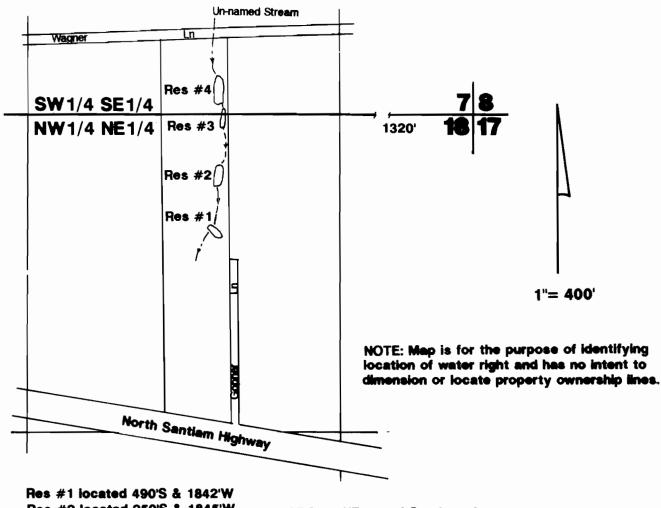

Res #2 located 250'S & 1845'W

Res #3 located 30'S & 1804'W

Res #4 located 50'N & 1817'W

All from NE cor of Section 18

Final Proof Survey

Application #:

Water Right &

R-69414

Permit #:

R-10898

R-69415

50203

UNDER

Donald L. Bult

Surveyed Sept. 13, 1989 by JMS