


T.6S., R.1W., W. M.

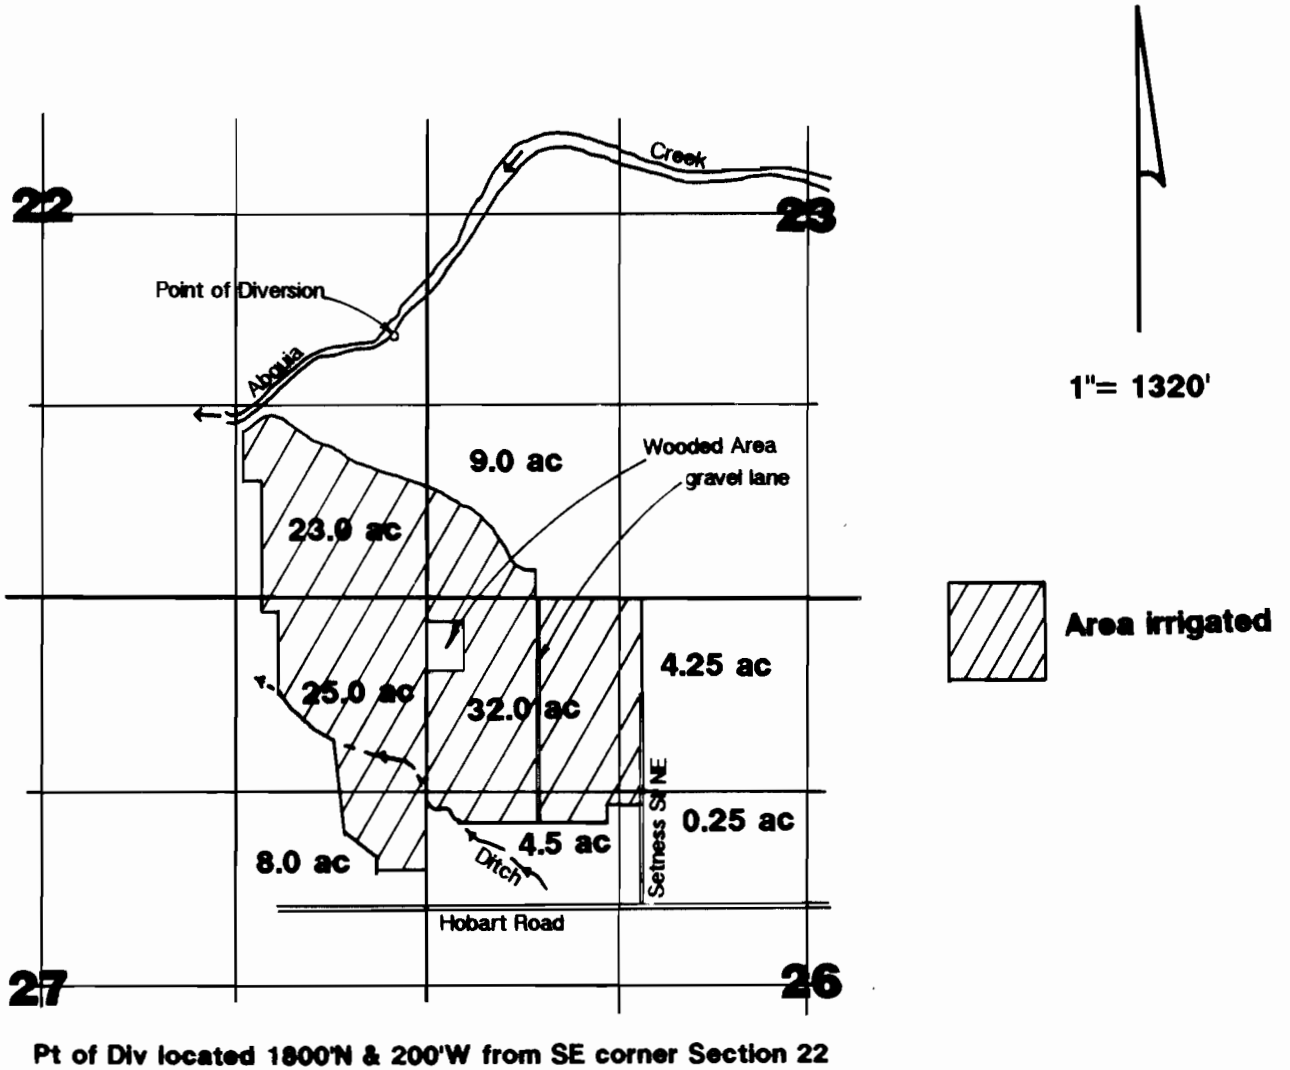

Final Proof Survey

Application #: 69457

Permit #: 50440

UNDER

David J. Pembroke

Surveyed May 31, 1989 by JMS

Note: This map is for the purpose of identifying location of water rights and has no intent to dimension or locate property ownership lines.

