


Township 9 South, Range 3 East, W. M.

A Portion of Section 30

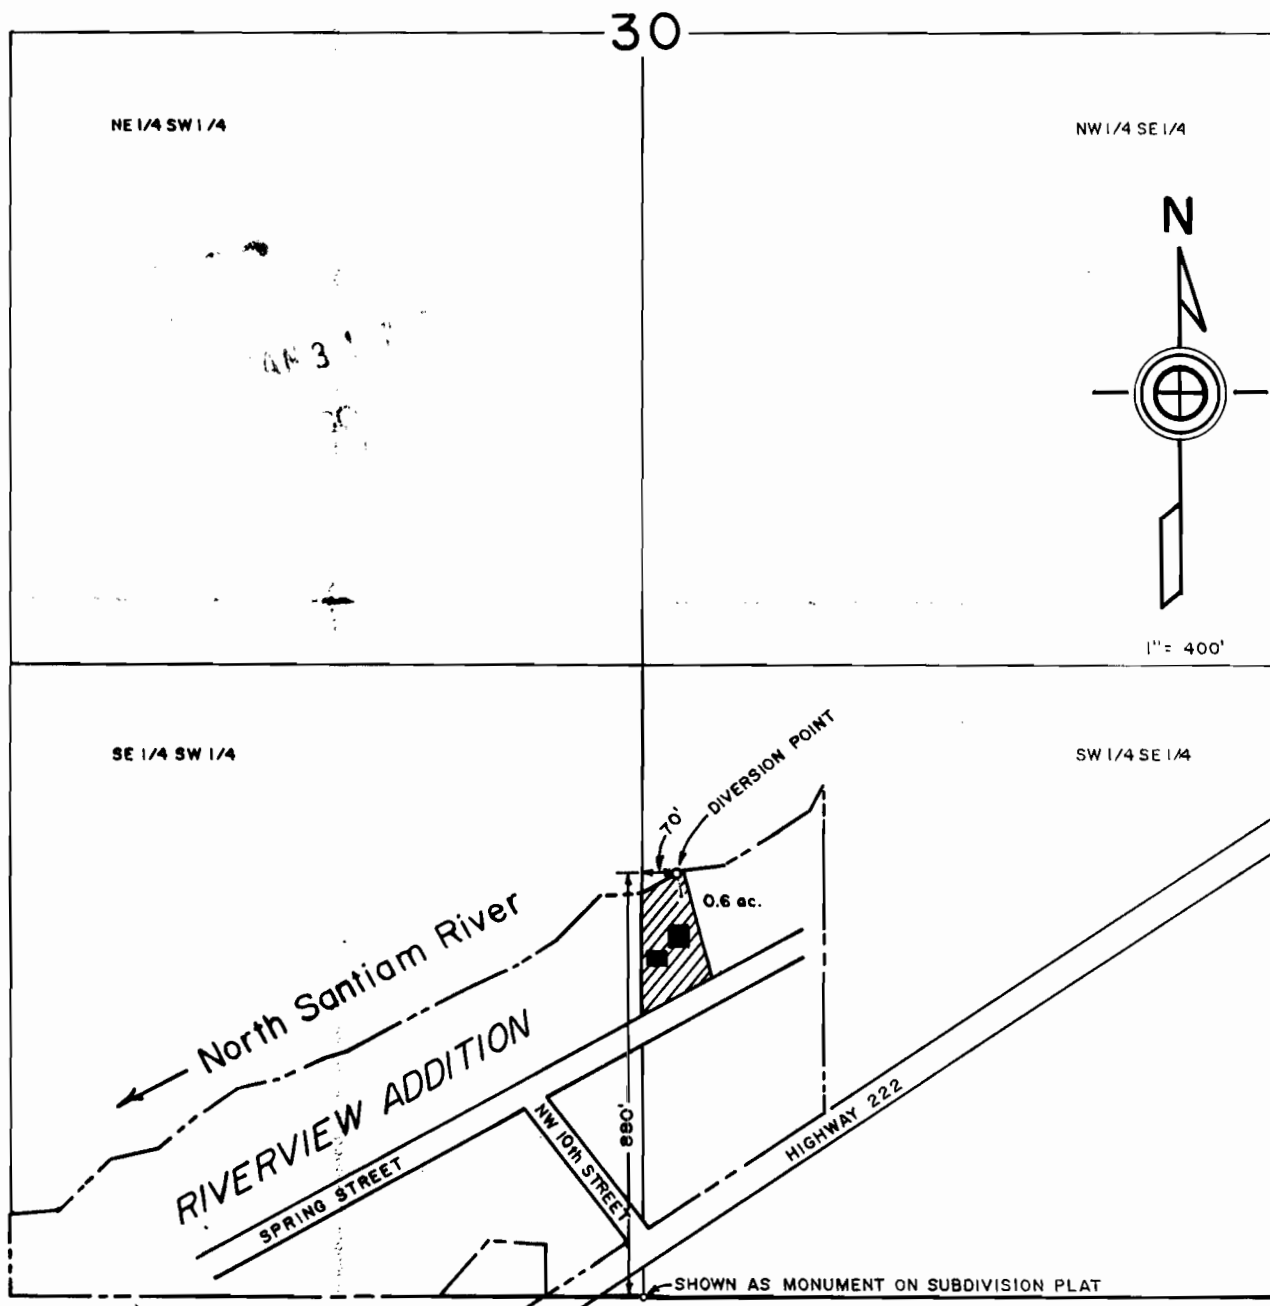

FINAL PROOF SURVEY

under

Appl. No. 69461, Per. No. 50378

in name of

ROBERT L. STEWART



THIS MAP WAS PREPARED FOR THE PURPOSE OF IDENTIFYING THE LOCATION OF A WATER RIGHT ONLY AND IS NOT INTENDED TO PROVIDE LEGAL DIMENSIONS OR LOCATION OF PROPERTY OWNERSHIP LINES.