


RECEIVED

OCT 24 1987

T. 7 S. R. 5 W. W. M.

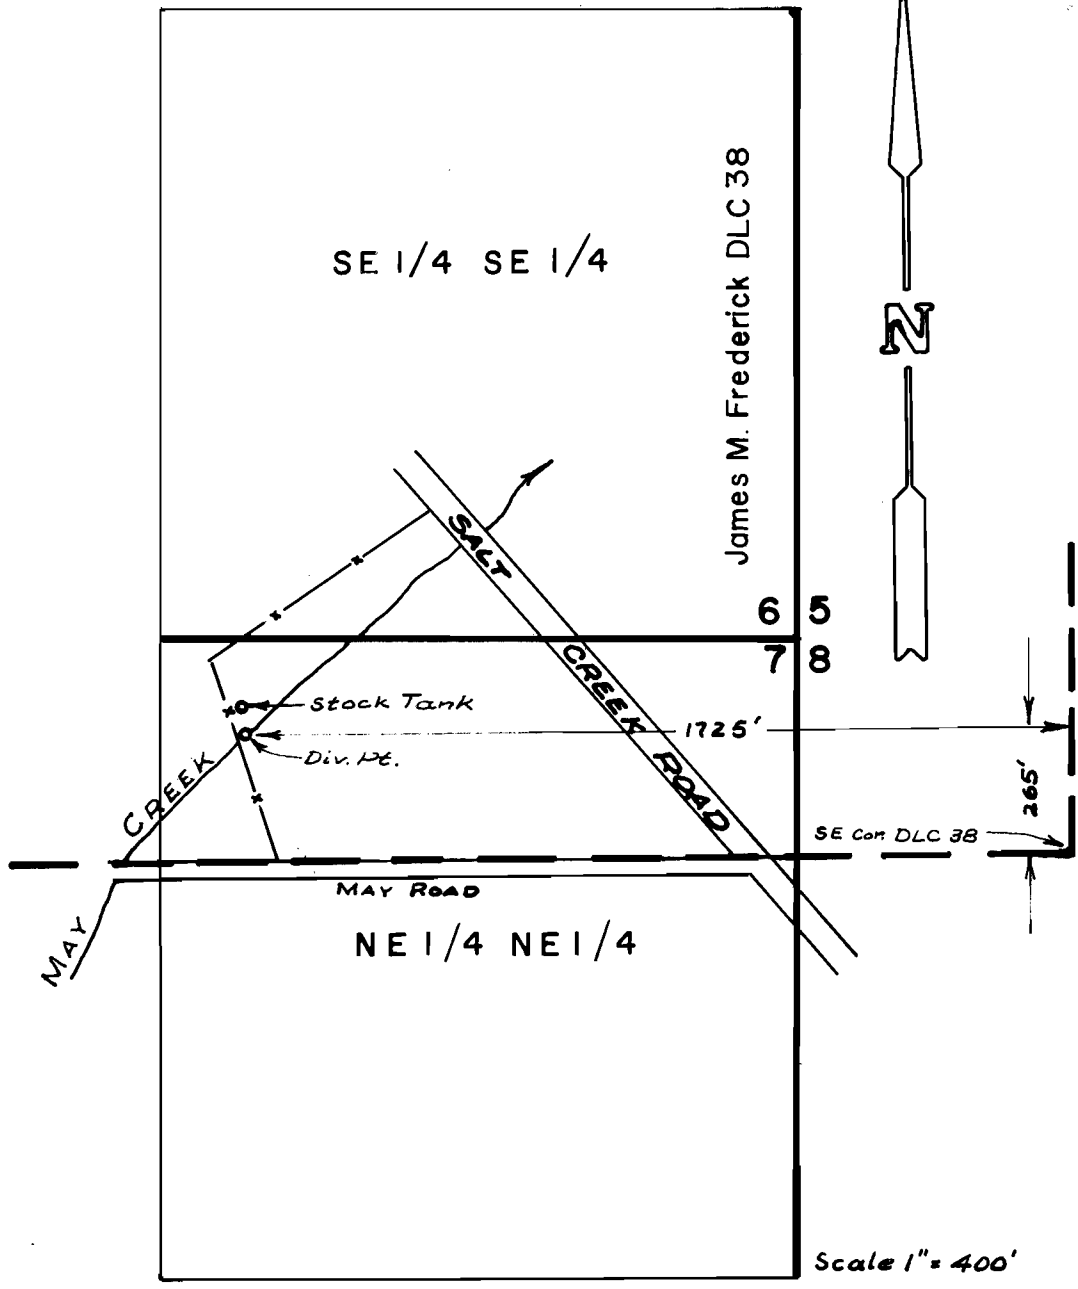

CLAIM OF BENEFICIAL USE
 UNDER APPLIC. No. 69541 PER.No. 50415
 IN NAME OF
 DONALD GUENTHER

THE PREPARATION OF THIS MAP IS FOR THE
 PURPOSE OF IDENTIFYING THE LOCATION
 OF THE WATER RIGHT ONLY AND HAS NO
 INTENT TO PROVIDE DIMENSIONS OR LOCATION
 OF PROPERTY OWNERSHIP LINES.

