
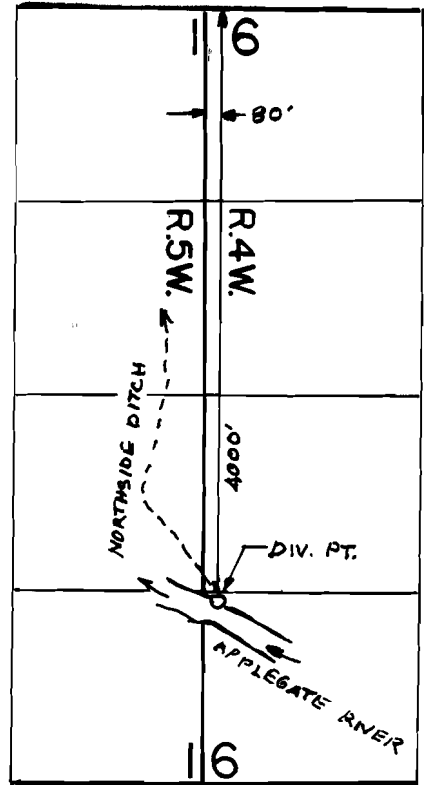


T.37S., R.5W., W.M.

T.38S., R.4 & 5W., W.M.

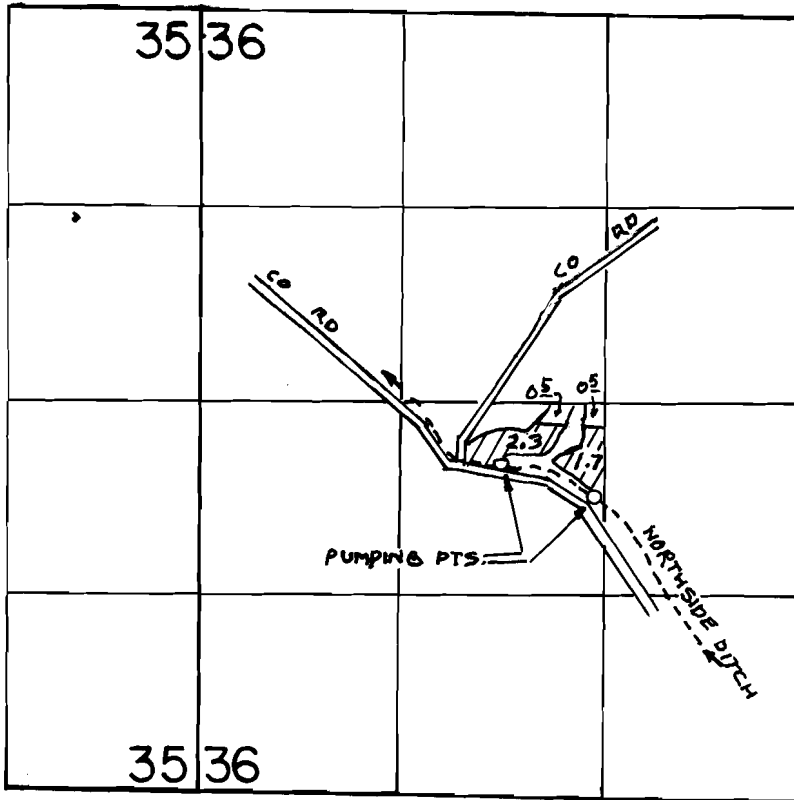

SCALE = 1" = 1320'

**FINAL PROOF SURVEY**  
UNDER

Application No. 61918.. Permit No. 45937....  
IN NAME OF

JAMES G. & JULIA M. BEGG.....

Surveyed NOV. 11.... 1984., by B.S. JAMES.....