


T.29S.R.5W. W.M.

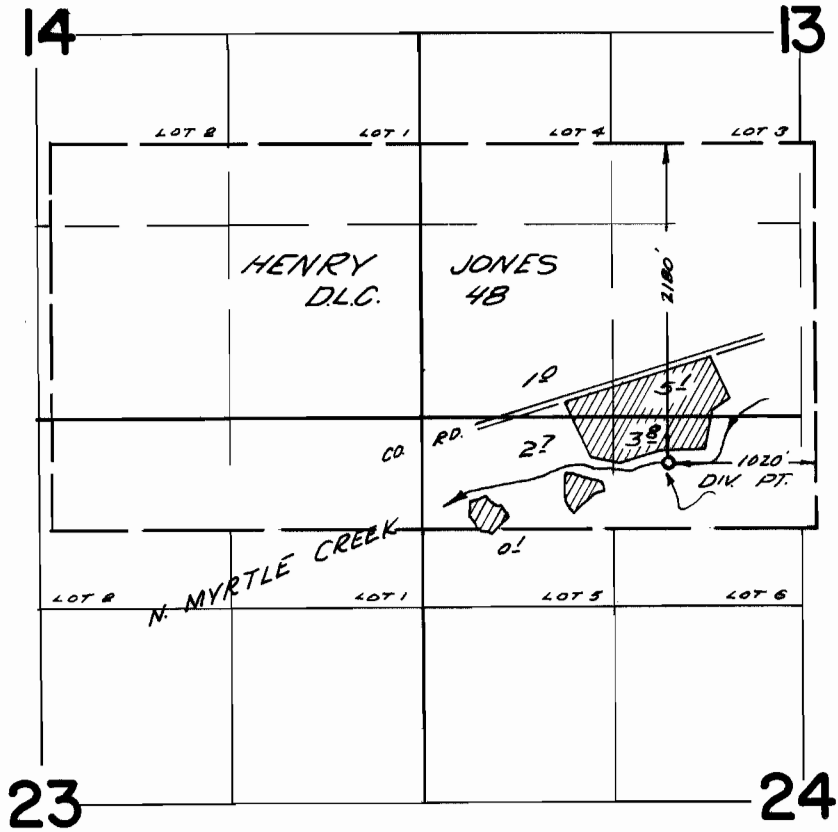

FINAL PROOF SURVEY  
UNDER

Application No. 37441 Permit No. 27879  
IN NAME OF

VICTOR J. RICE

Surveyed Sept 19, 1967, by V. Garner