


T. 14 S., R. 5 W., W.M.

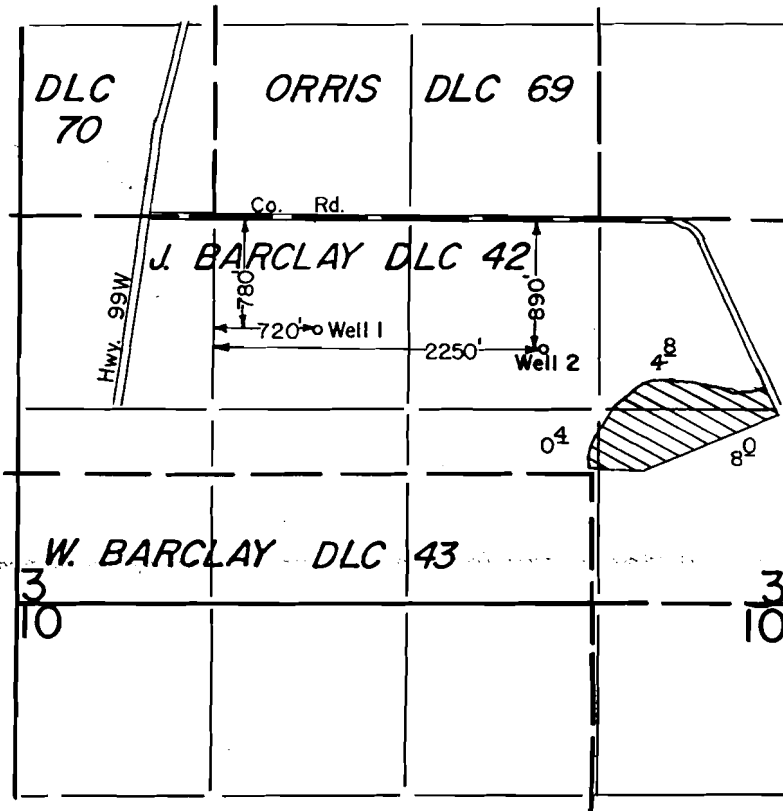

Scale: 1" = 1320'

### FINAL PROOF SURVEY

UNDER

TRANSFER 5263

Application No. G-10961.. Permit No. G-10147.....  
IN NAME OF

DAVID BARCLAY

Surveyed Nov. 13..... 1987., by T. Warren.....

41003-178-44A  
2/9/89 TMW