

CANCELLED
 V49 P324

T.4N. R.27&28 E.W.M.

T-6405

SUPERSEDED BY

Cont. 76730

76731


76732

V. 55 P. 36
 WID 3111

35784

76731

64731

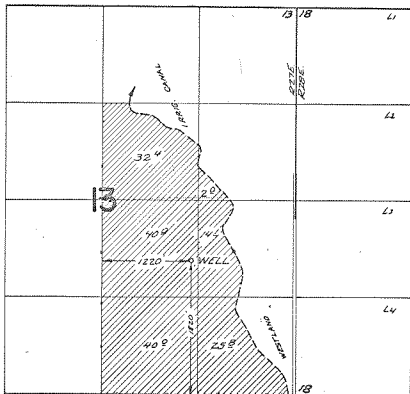

FINAL PROOF SURVEY
 UNDER

Application No. G-2809.. Permit No. G-2620..
 IN NAME OF

FLOYD A. OMAN

Surveyed June 22 1967, by L.E. Goid.....