


T. 7 S. R. 1 E. W. M.

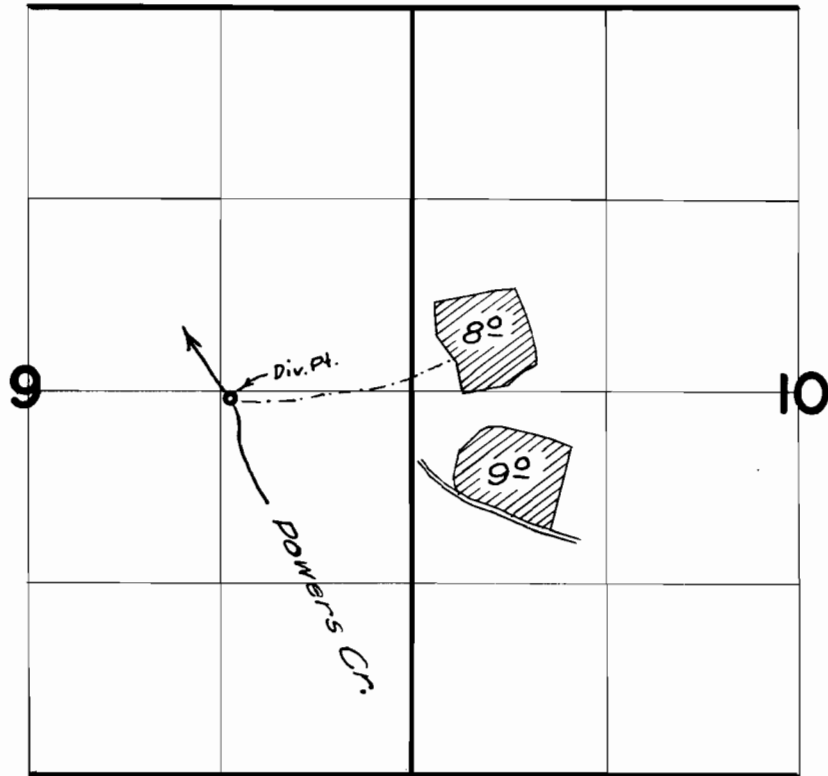

**FINAL PROOF SURVEY**  
UNDER

Application No. 31084 Permit No. 24599  
IN NAME OF

BETTY LEIGHTY DARLING & JAMES W. DARLING

Surveyed 22 April 1960, by m. Bish