


T. 7&8 S., R. 1 E., W. M.

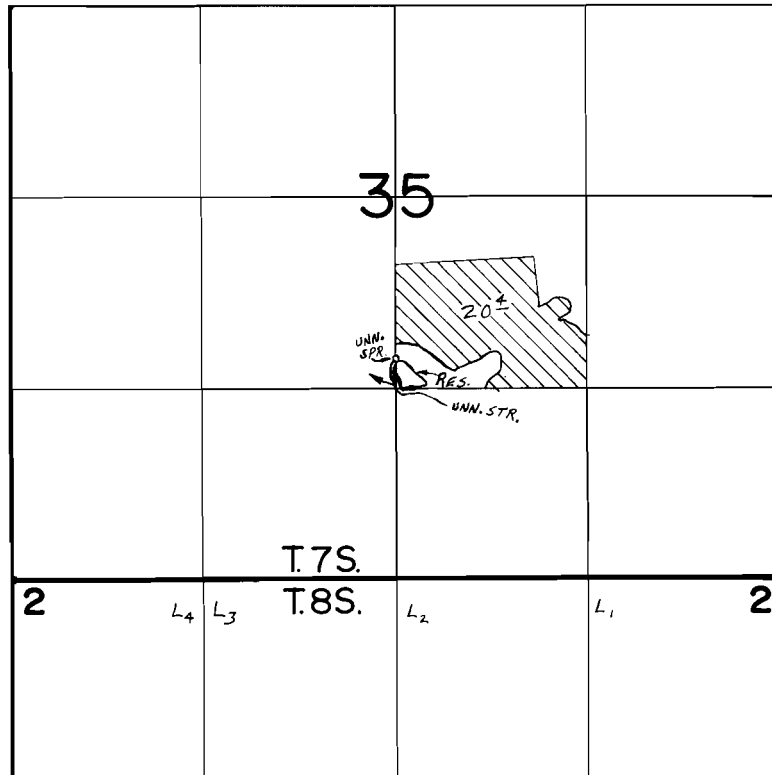

Dam Loc. : 1330' N. & 50' E. from S. 1/4 Cor. Sec. 35.

Scale: 1" = 1320'

FINAL PROOF SURVEY

UNDER

R-42912

R-4992

Application No. 42913 Permit No. 32491.....
IN NAME OF

THEODORE & KATHERINE ALLEN

Surveyed May 1 1986, by T. Warren.....

41047-178-14R
+ Zoom
TMW 11/18/86