


T.9S., R.3W., W.M.

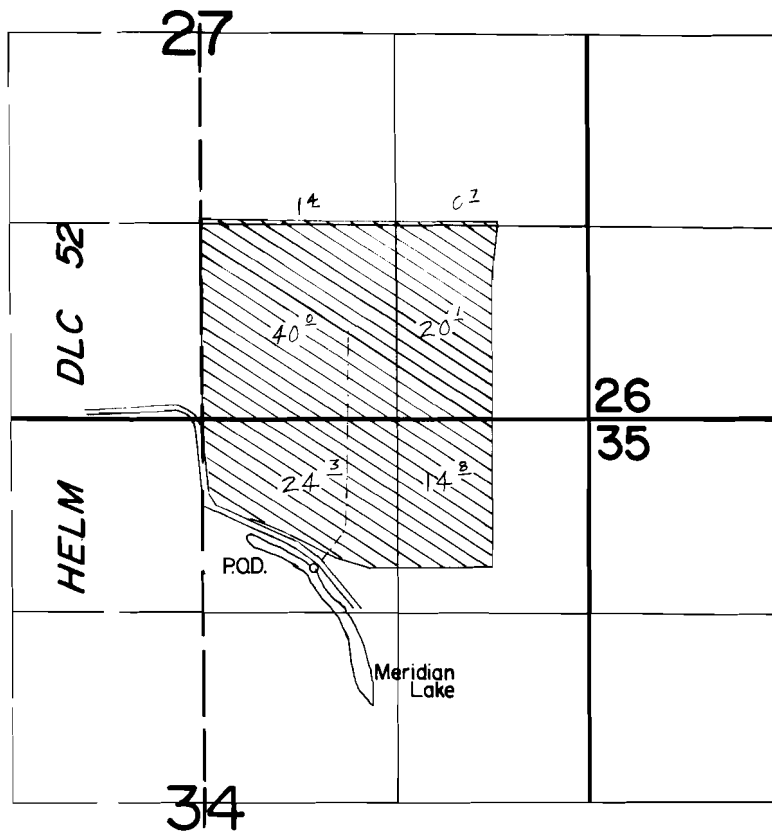

P.O.D. Loc. : 1610' N. & 1890' W. from E. 1/4 Cor. Sec. 34.

Scale: 1" = 1320'

FINAL PROOF SURVEY UNDER

Application No. 54455.. Permit No. 40850.....

IN NAME OF

DUANE G. BEARD

Surveyed Oct. 3, 1977, by S. Brown.....

& Sept. 25, 1986, by T. Warren

DFN-6LL-34
+ Zoom
12/23/86 TMW