


T.10S. R.2W. W.M.

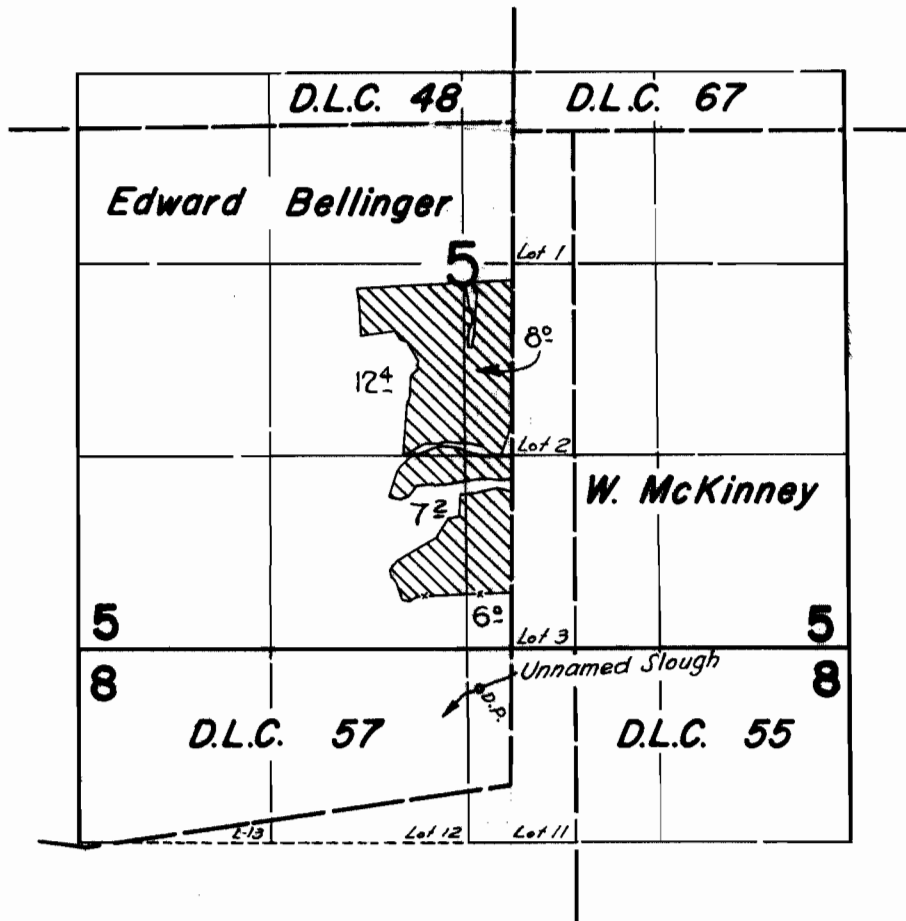

FINAL PROOF SURVEY
UNDER

Application No. 32960... Permit No. 26066.
IN NAME OF

FLORA B. THOMAS

Surveyed June 22, 1962, by *R. Jackson*