


# T.10S.R.2W. W.M.

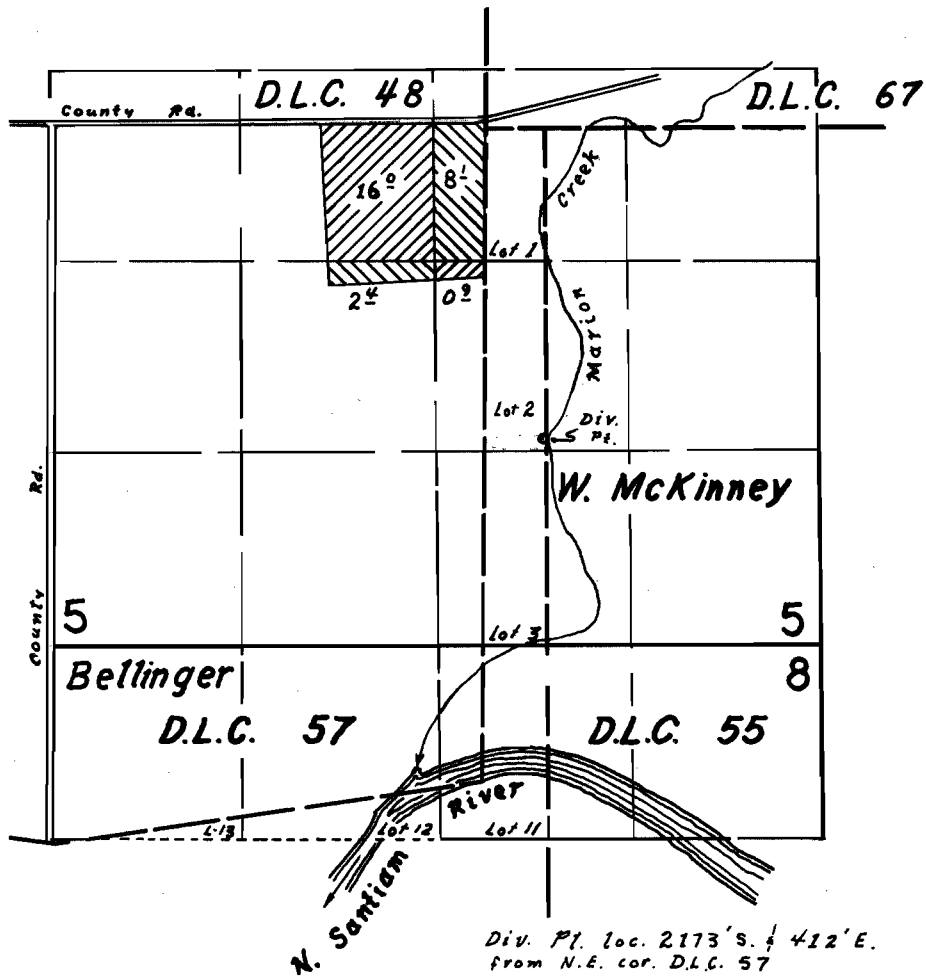

## FINAL PROOF SURVEY UNDER

Transfer No. *p-92*

Application No. *44394* Permit No. *33161*

IN NAME OF

**ROBERT L. LEABO**

Surveyed *19 OCT* 1972, by *A. O'Reilly*