


T. 23S., R. 32 1/2 E., W.M..

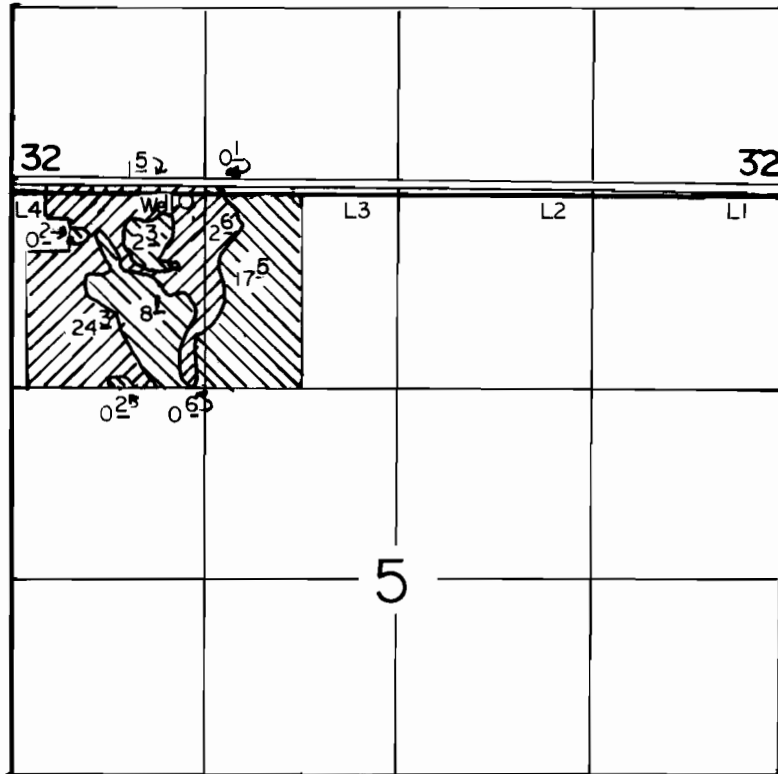

Well Located 40' S & 1200' E From NW Corner Section 5

SCALE: 1" = 1320'



FINAL PROOF SURVEY
UNDER

Application No. G-8904 Permit No. G-8310
IN NAME OF

DWIGHT & LYNN MIMS

Surveyed JULY 16, 1986, by DON CLARK