


T. 1 S., R. 4 E., W.M.

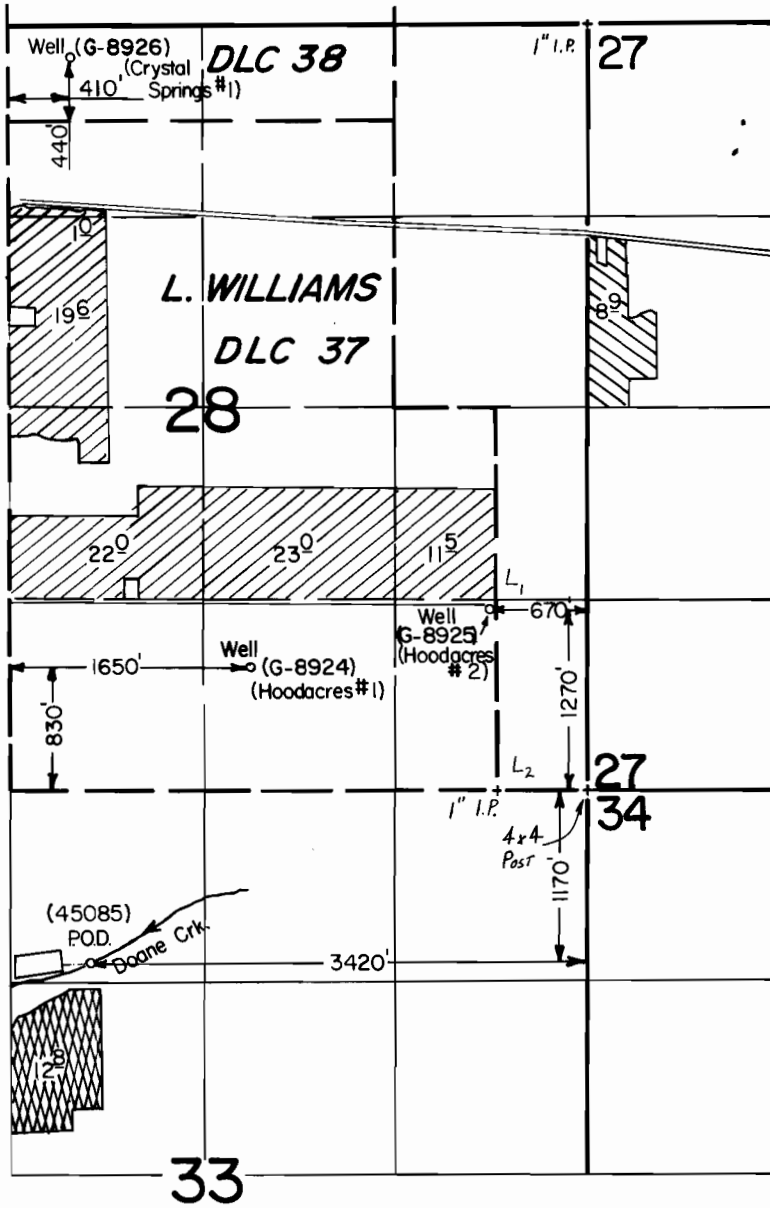

Scale: 1" = 1320'

FINAL PROOF SURVEY

UNDER

60484
G-9881
G-9882

45085
G-8924
G-8925



*Primary
Supplemental*

Application No. G-9883.. Permit No. G-8926

IN NAME OF

J. FRANK SCHMIDT & SON CO.

Surveyed Oct...9..... 1986., by T. Warren.....