


T.17S.,R.15E.,W.M.

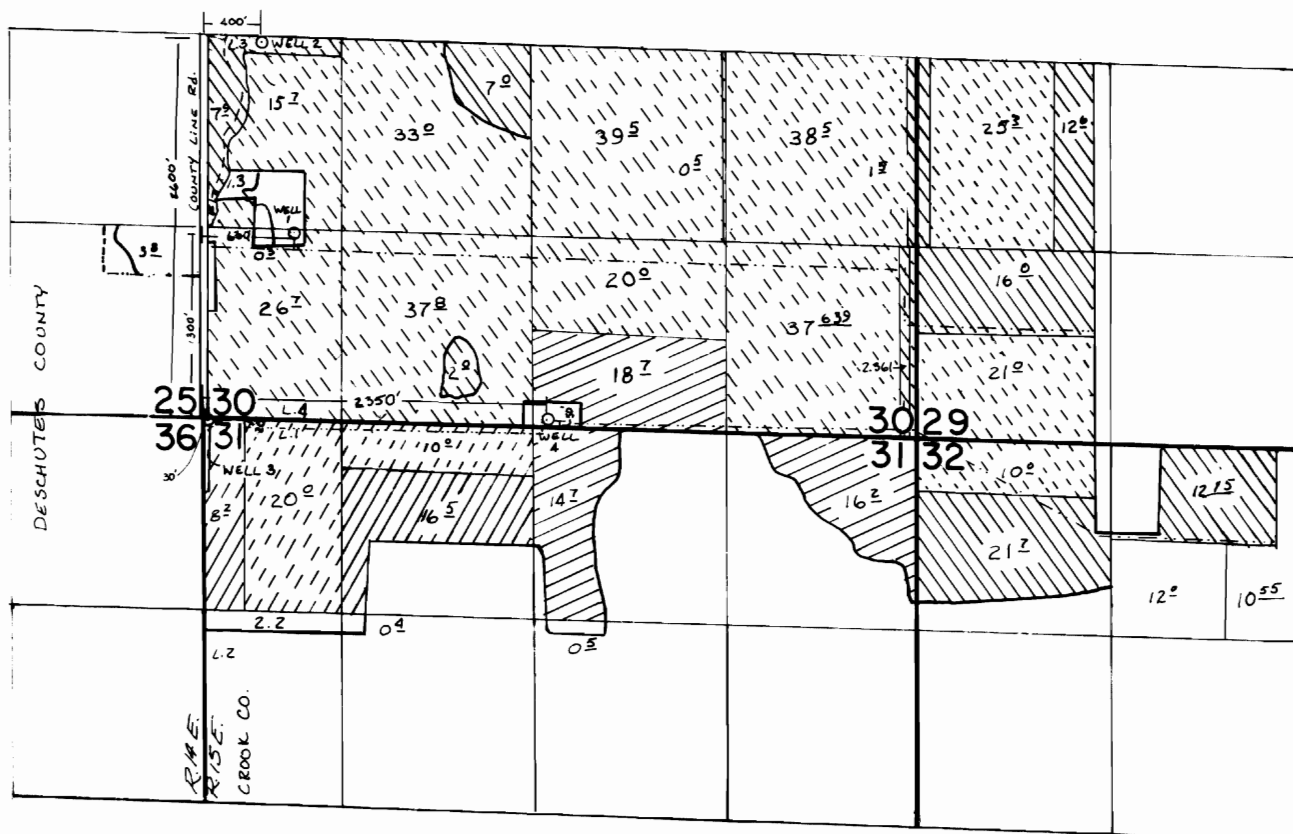

SCALE: 1"=1320'

Well #	Primary	Supplemental
1 & 2		
3		
4		

FINAL PROOF SURVEY UNDER

Application No. G-10003 Permit No. G-10319
IN NAME OF

WAYNE P. SINGHOSE

Surveyed SEPT. 4, 1984, by L. OLSON

