


T. 33 S., R. 18 E., W. M.

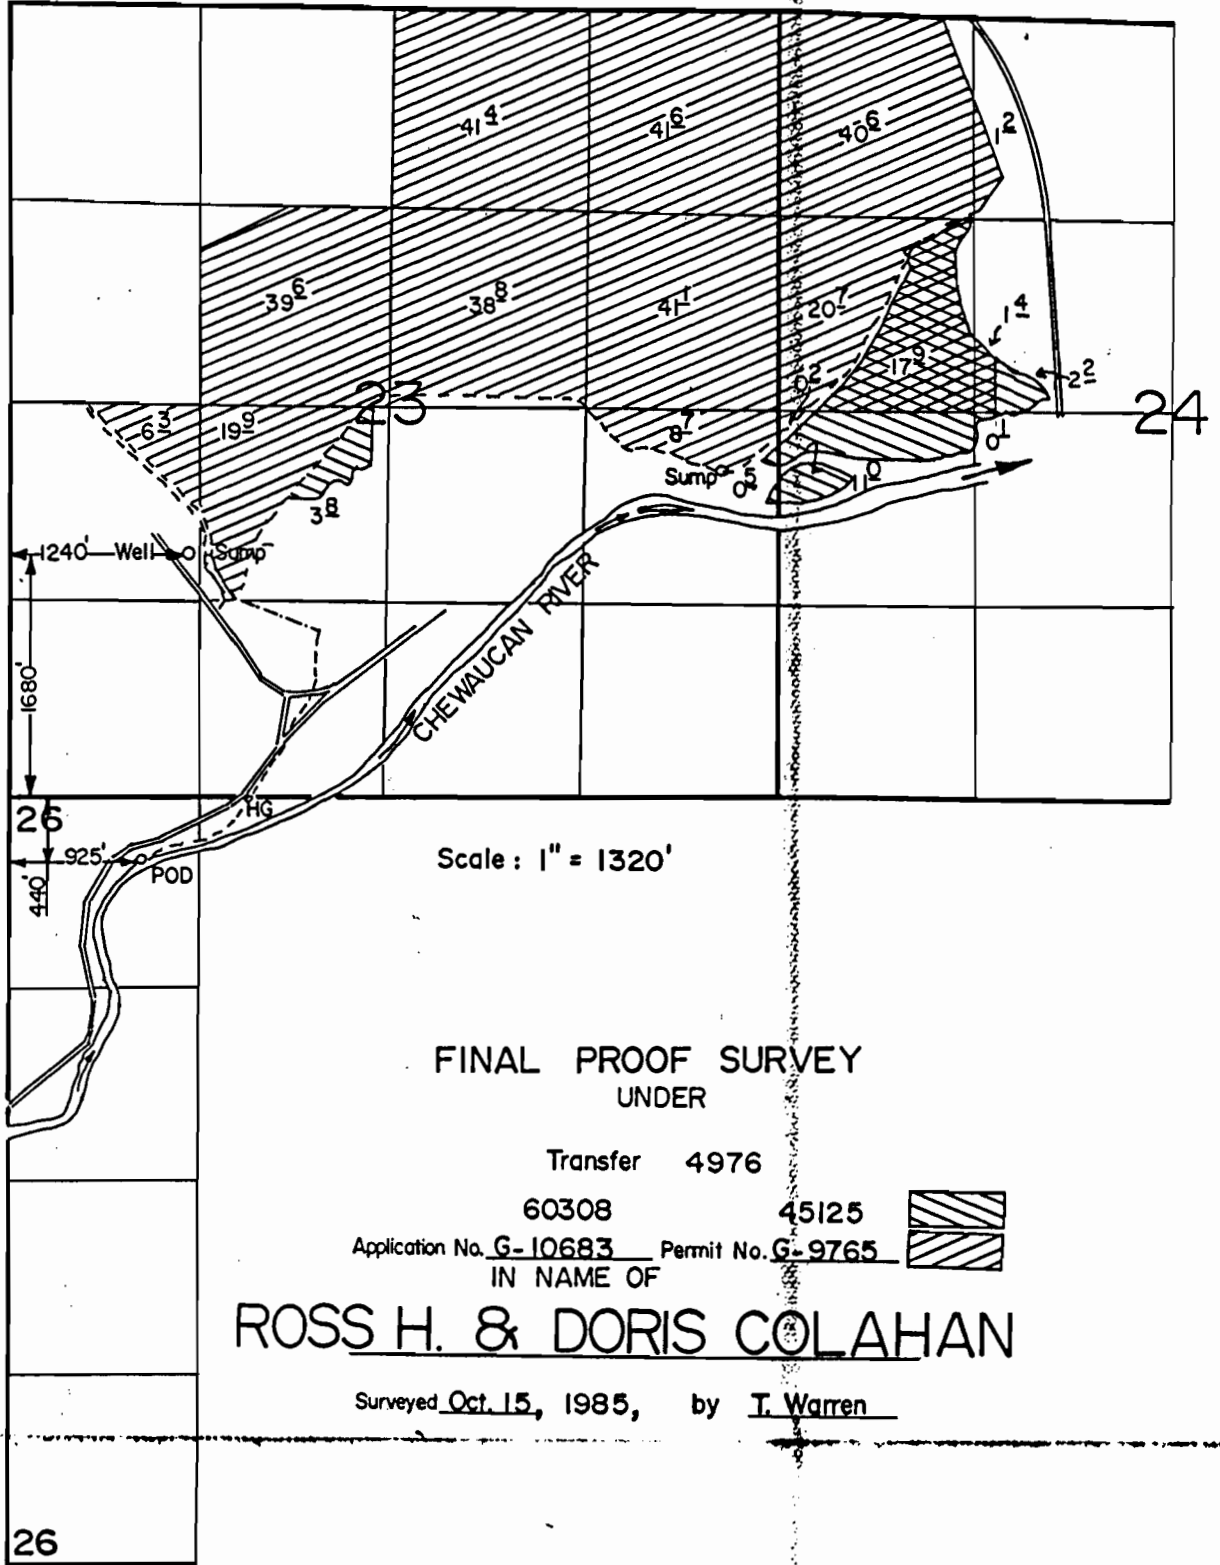

Scale: 1" = 1320'


FINAL PROOF SURVEY  
UNDER

Transfer 4976

60308

45125

Application No. G-10683 Permit No. G-9765

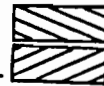

IN NAME OF

**ROSS H. & DORIS COLAHAN**

Surveyed Oct. 15, 1985, by T. Warren