


T.33S. R.18E. W.M.

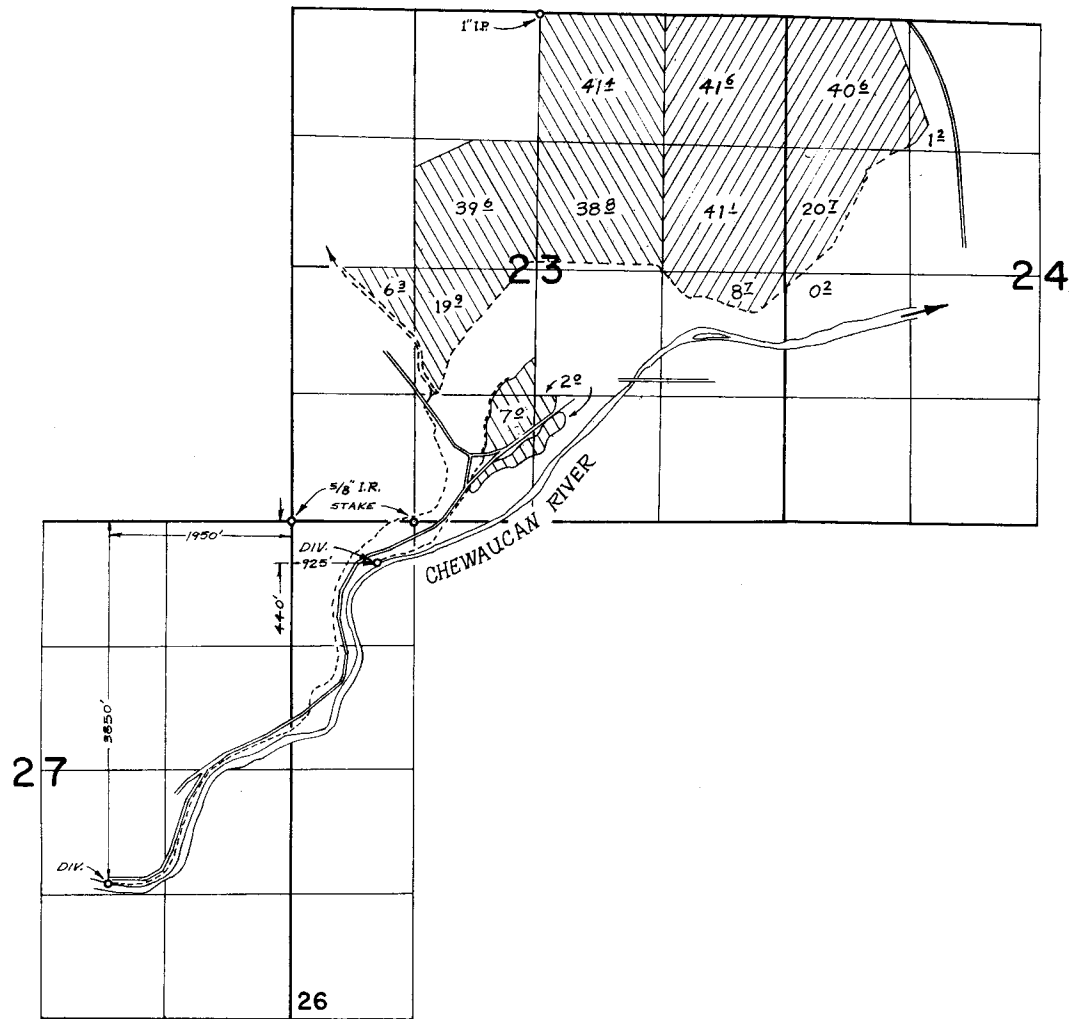

FINAL PROOF SURVEY

UNDER
 12939 31344
 12542 31395
 Application No. 39812 Permit No. 29881
 IN NAME OF
 ROSS H. & DORIS COLAHAN
 Surveyed AUGUST 29 1973, by R. MUCKEN

