


T. 36 S., R. 7 W., W. M.

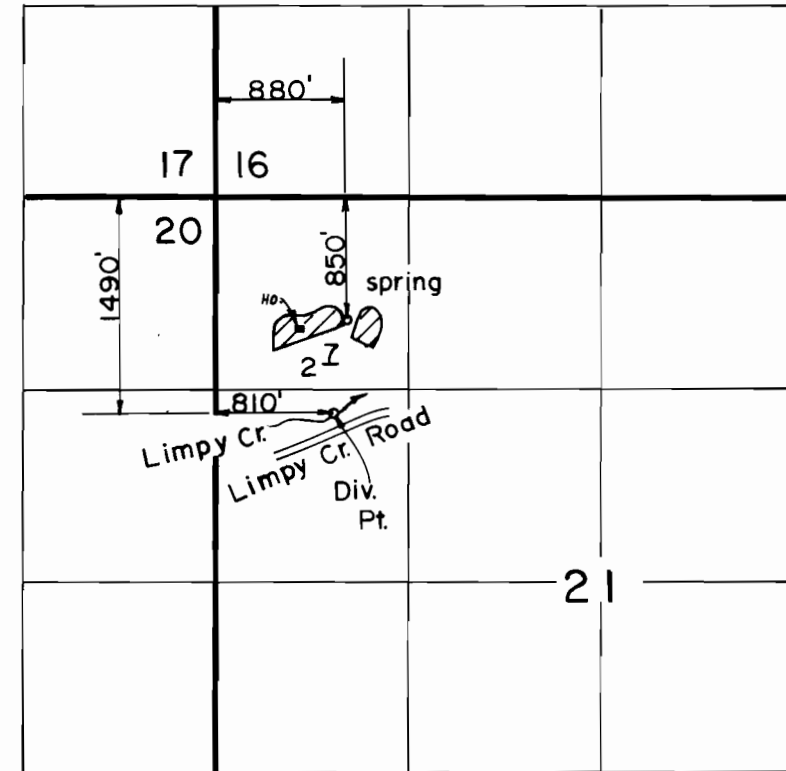

Scale: 1" = 1320'

FINAL PROOF SURVEY
UNDER

Application No. 49136. Permit No. 36844
IN NAME OF

DONALD W. PORTER

Surveyed AUG. 31. 1988, by B. S. JAMES