


T. 35 S., R. 7 W., W.M.

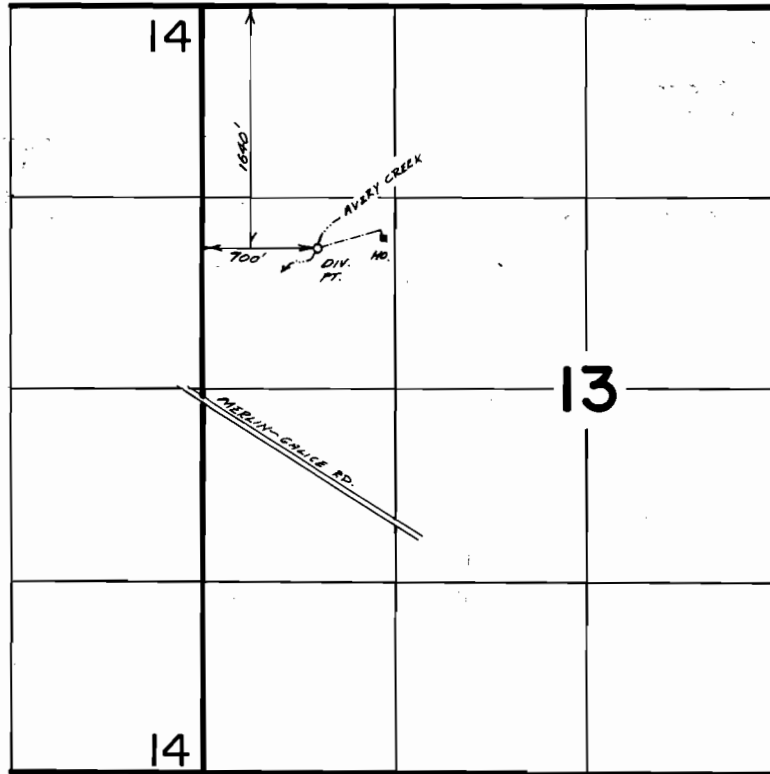

Scale 1"=1320'



FINAL PROOF SURVEY UNDER

Application No. 50138.. Permit No. 37671.....
IN NAME OF

...RONALD JAMES THOMPSON...

Surveyed Oct. 26., 1987, by B.S. JAMES.....