


T. 29 S., R. 4 W., W.M. SECTION 5

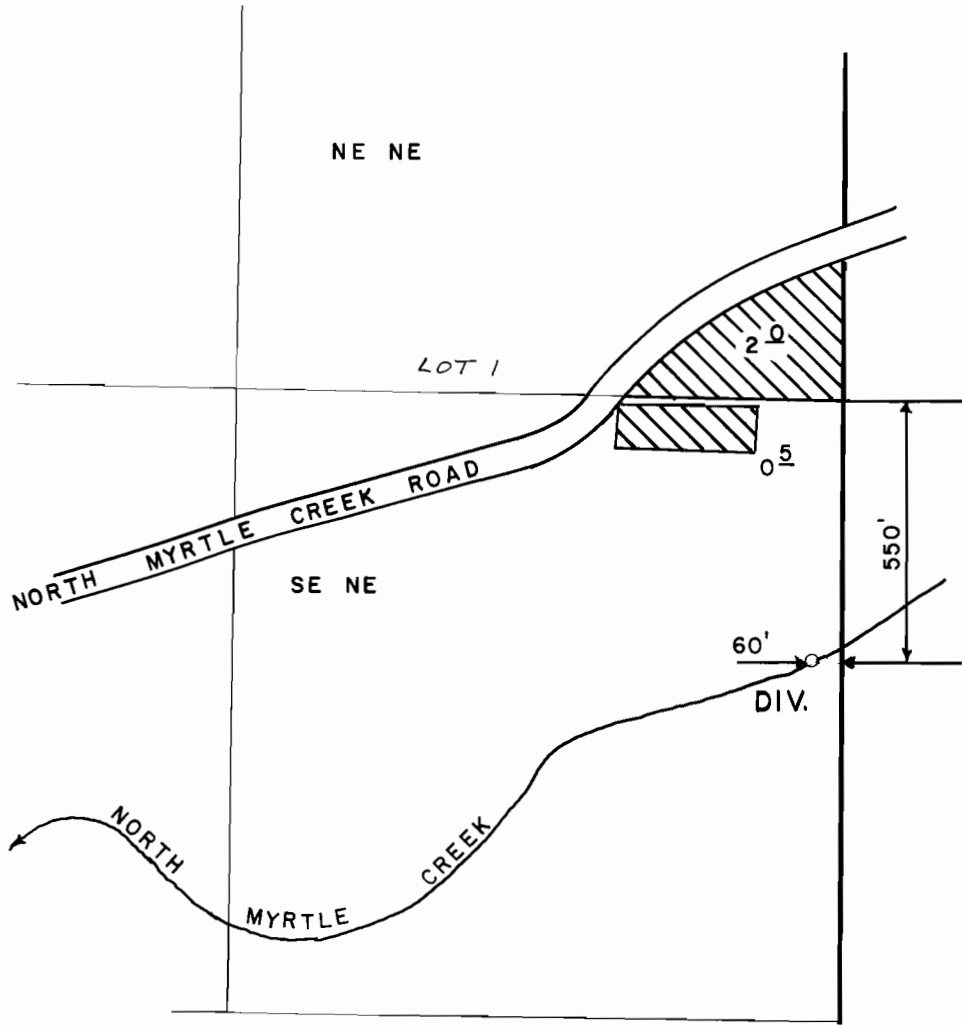

SCALE: 1" = 400

FINAL PROOF SURVEY UNDER

Application No. 50274 Permit No. 37708
IN NAME OF

JAKE TAVENNER

Surveyed JULY 24 1975, by L. E. GOULD