


T. 27S., R. 13W., W. M.

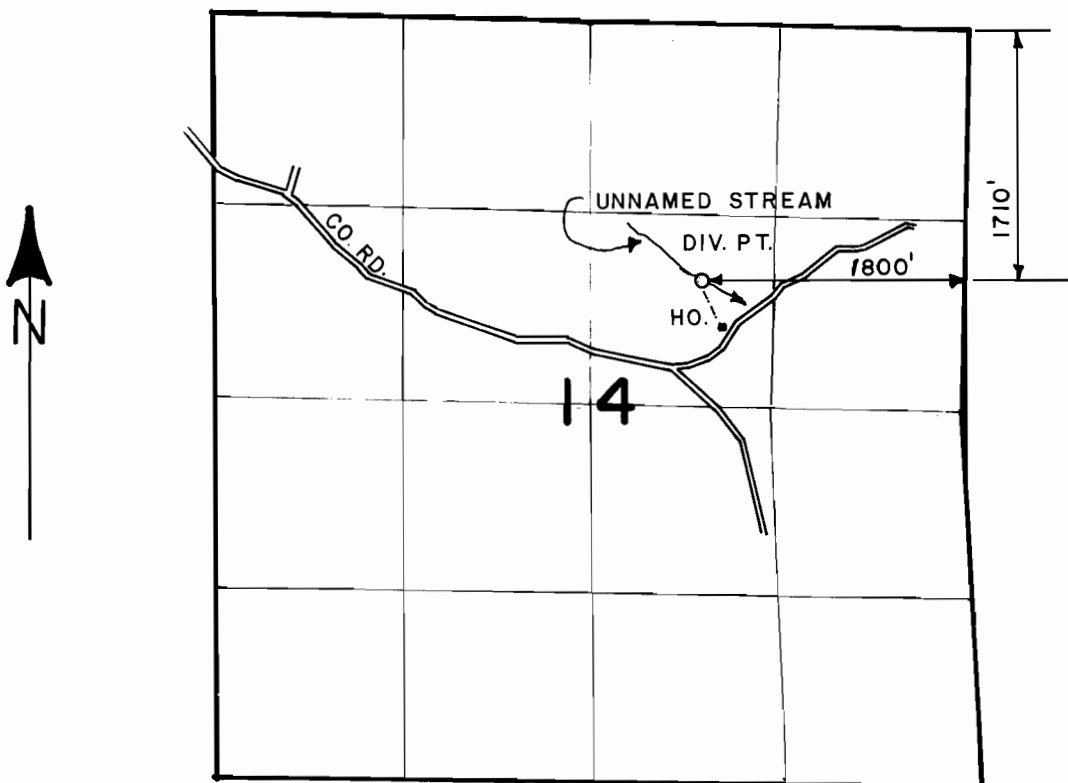

SCALE: 4" = 1 MILE

FINAL PROOF SURVEY

UNDER

Application No. 50379 Permit No. 38027
IN NAME OF

MARY HUMPHREY

Surveyed OCT. 17 1983, by L. E. CASHION