


T. 32 S., R. 4 W., W. M.

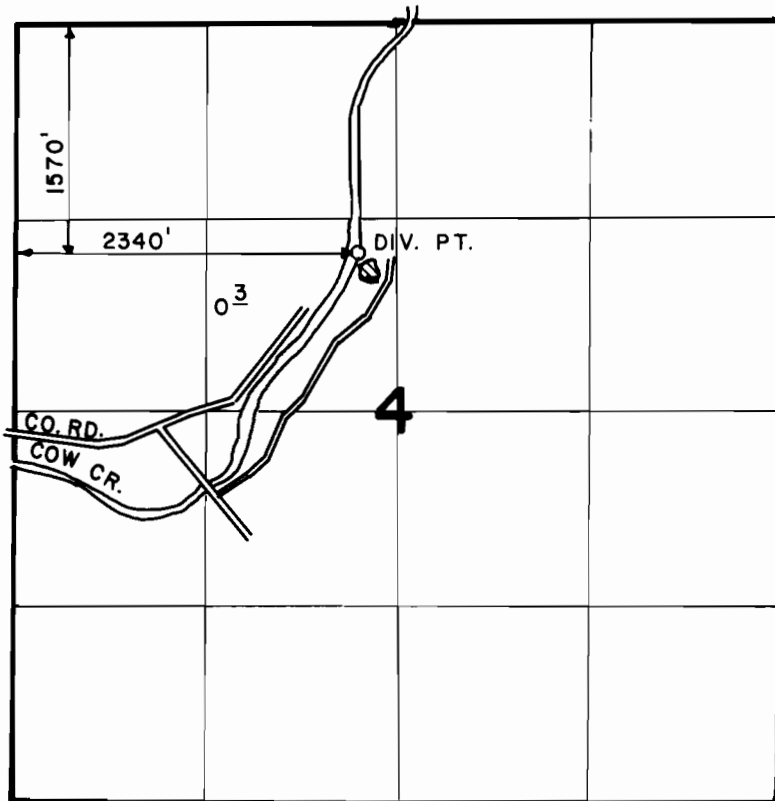

SCALE: 4" = 1 MILE

FINAL PROOF SURVEY
UNDER

Application No. 50718... Permit No. 38308.....
IN NAME OF

DANIEL & PATRICIA LYNCH

Surveyed JULY 6... 1988, by J. M. SCHMORDE