


# T. 32 S., R. 4 W., W.M.

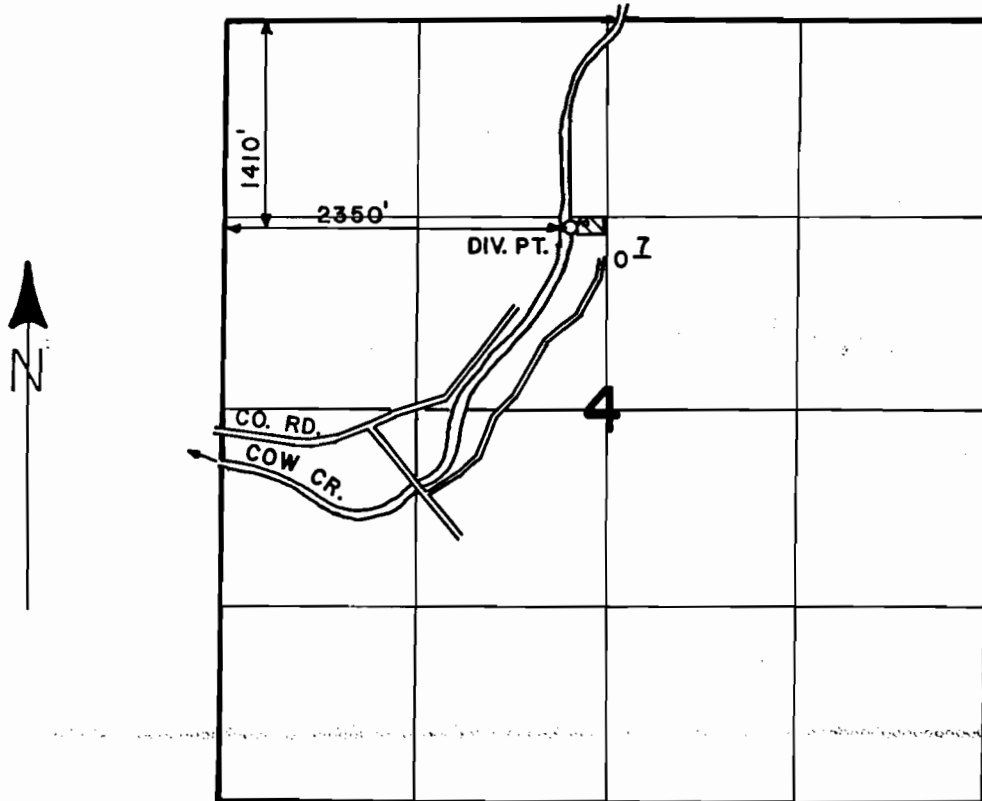

SCALE: 4" = 1 MILE

## FINAL PROOF SURVEY UNDER

Application No. 50736 Permit No. 38320  
IN NAME OF

DANIEL & PATRICIA LYNCH

Surveyed JULY 6, 1988, by J. M. SCHMORDE