


T. 38 & 39 S., R. 7 W., W. M.

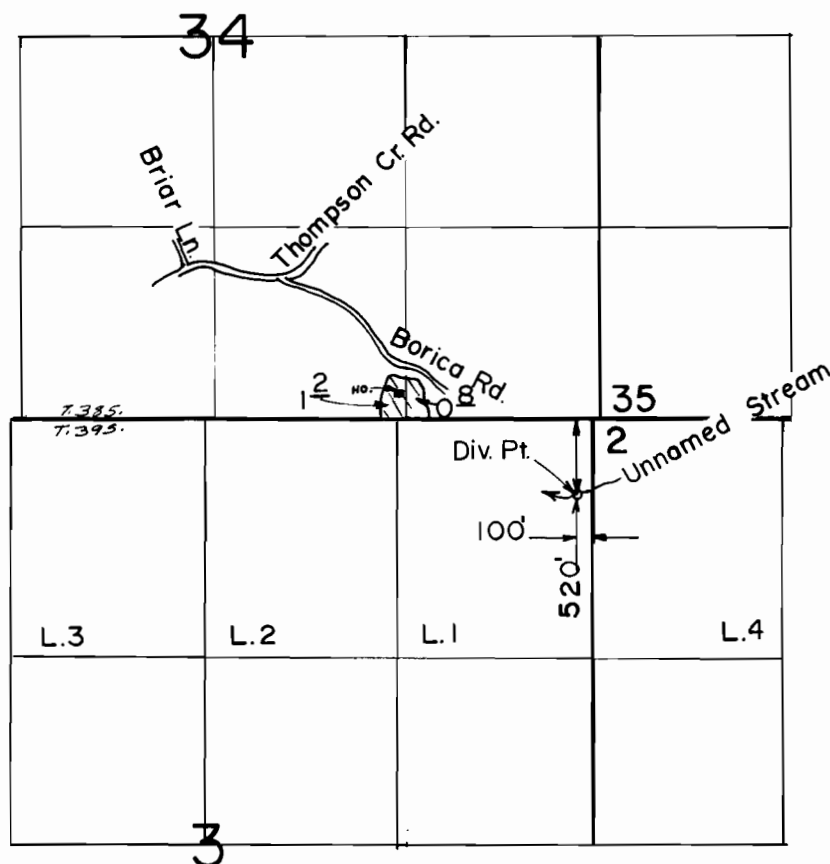

Scale: 1" = 1320'

FINAL PROOF SURVEY UNDER

Application No. 50914 Permit No. 38439
IN NAME OF

A. L. HOFFMAN

Surveyed MAY 18, 1988, by B. S. JAMES