


T. 30 S., R. 7 W., W. M.

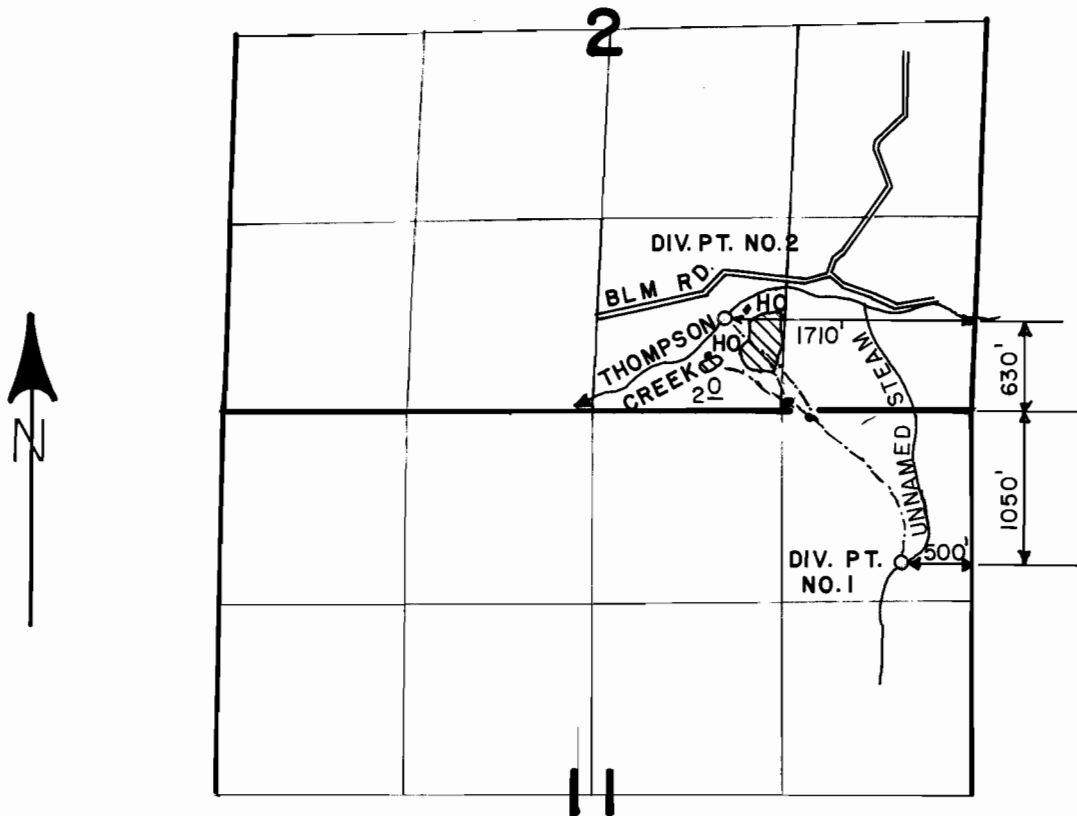

SCALE: 4" = 1 MILE

FINAL PROOF SURVEY

UNDER

Application No. 51073... Permit No. 38536.....
IN NAME OF

LARRY JORDAN

Surveyed JUNE 29, 1988, by J.M. SCHMORDE