


T. 31 S., R. 1 W., W. M.

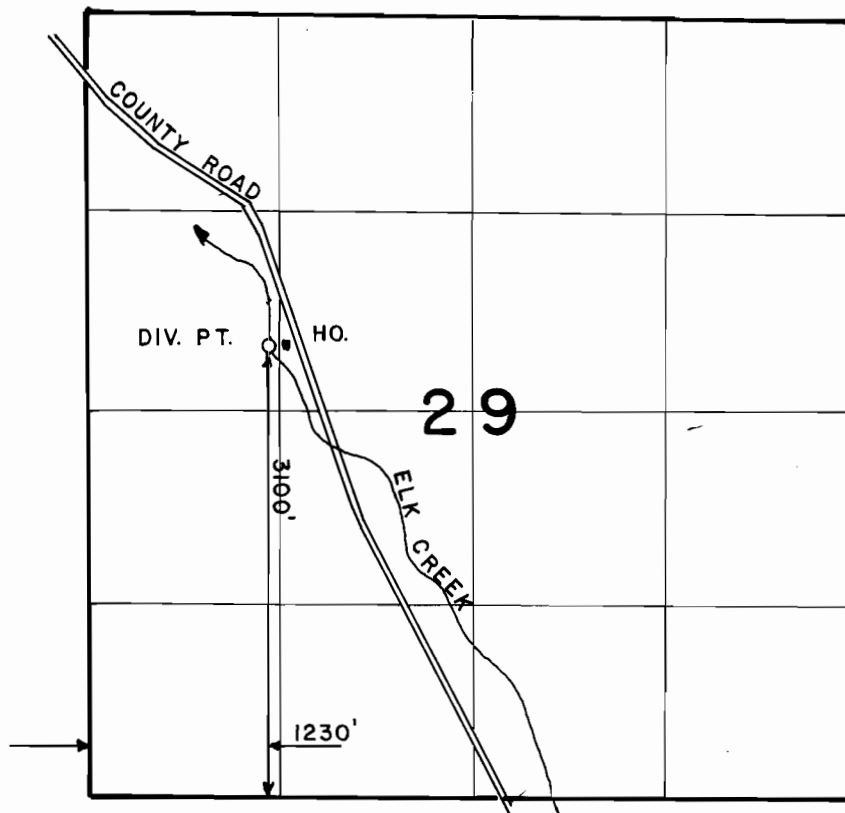

SCALE: 4" = 1 MILE

FINAL PROOF SURVEY

UNDER

Application No. 51106..... Permit No. 38555.....
IN NAME OF

CHARLES EDGAR JACKSON

Surveyed APRIL 5, 1988, by J.M. SCHMORDE