


T. 29 S., R. 5 W., W. M.

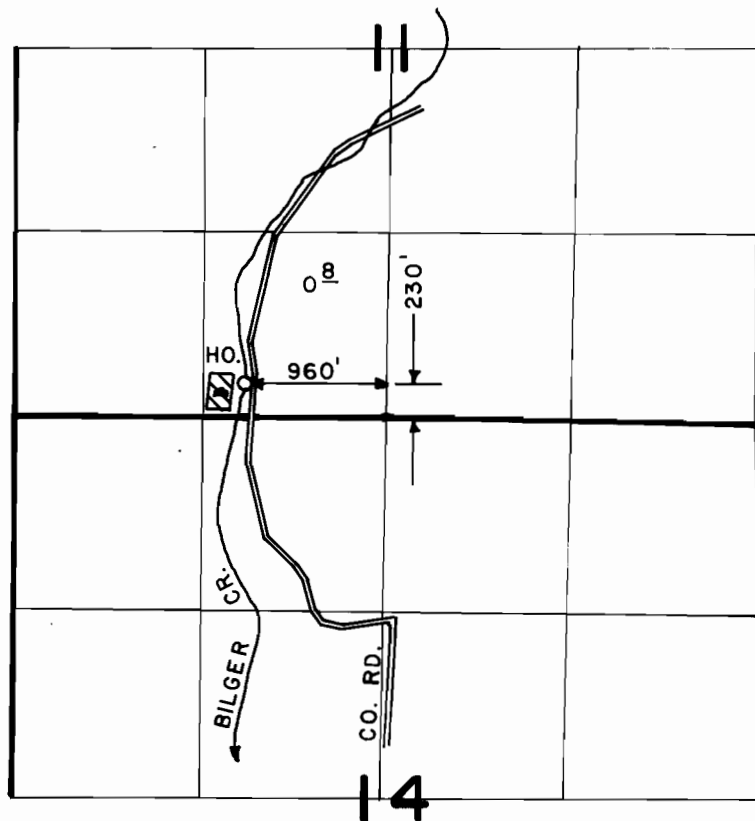

SCALE: 4" = 1 MILE

FINAL PROOF SURVEY
UNDER

Application No. 51114..... Permit No. 38561.....
IN NAME OF

R. D. & ARLENE Y. VREDENBURG

Surveyed DEC. 27. 1983., by D. K. CLARK.....