


T. 36 S., R. 5 W., W.M.

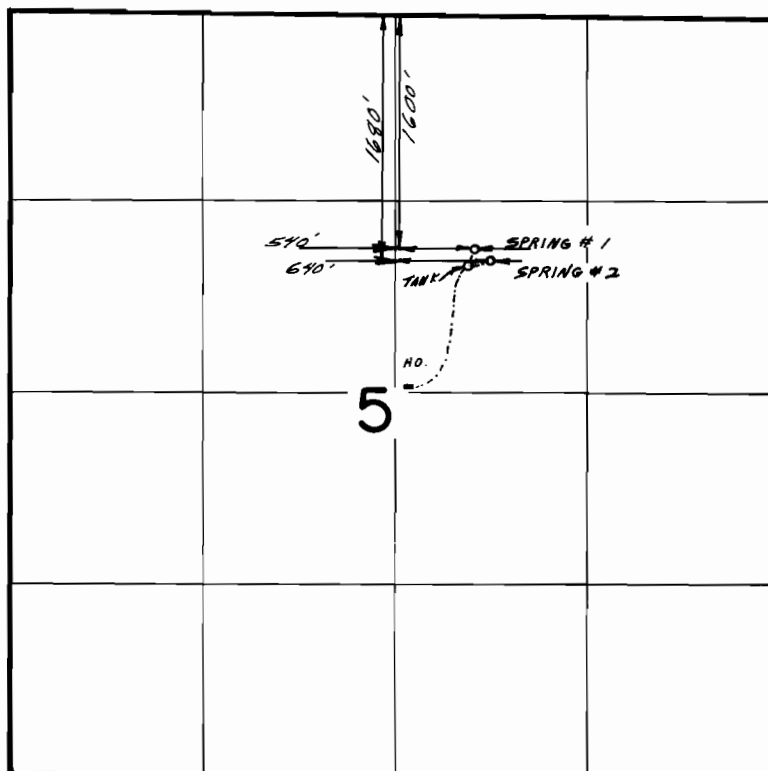

Scale: 1" = 1320'

FINAL PROOF SURVEY UNDER

Application No. 51516... Permit No. 40444.
IN NAME OF

.....JOHN.....M.....AUSLAND.....

Surveyed SEP...3.... 1988., by B....S....JAMES....