


T. 30 S., R. 7 W., W. M.

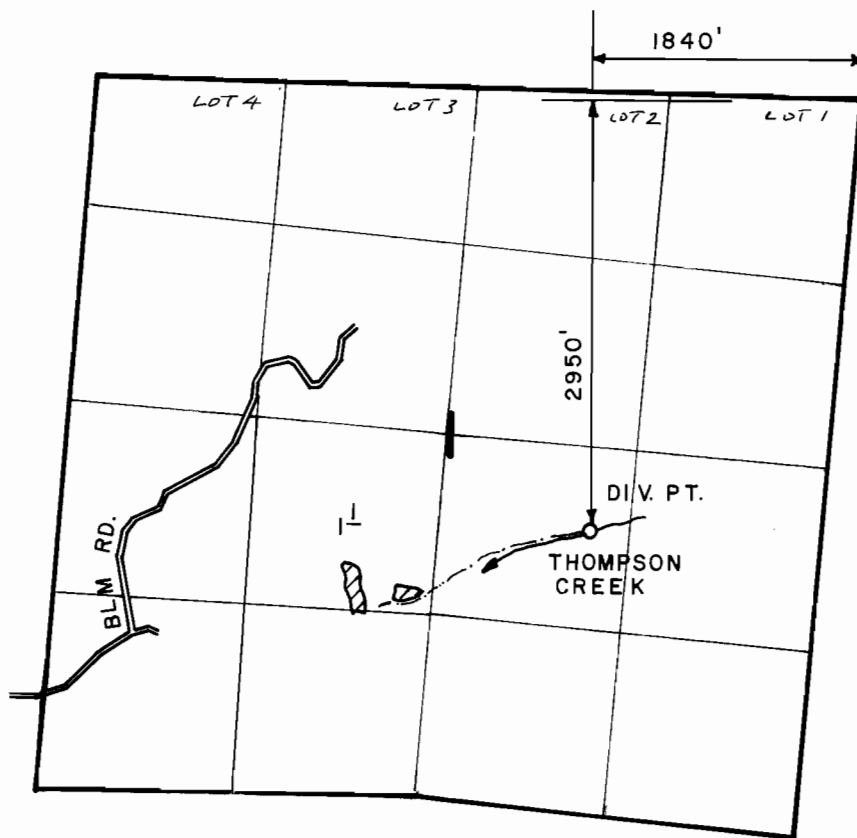

SCALE: 4" = 1 MILE

FINAL PROOF SURVEY

UNDER

Application No. 51704 Permit No. 38978
IN NAME OF

MARK EASON

Surveyed JUNE 29, 1988, by J. M. SCHMORDE