


T. 39 S., R. 8 W., W. M.

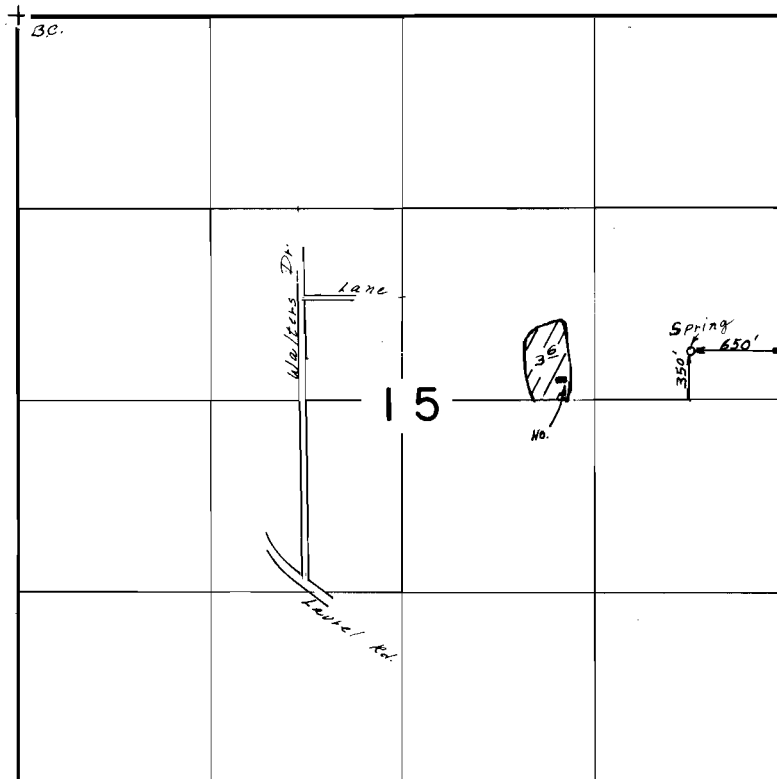

Scale: 1" = 1320'

FINAL PROOF SURVEY

UNDER

Application No. 51877 Permit No. 39153...
IN NAME OF

ROBERT L. WHITE

Surveyed MAY 17, 1988, by B. S. JAMES...