
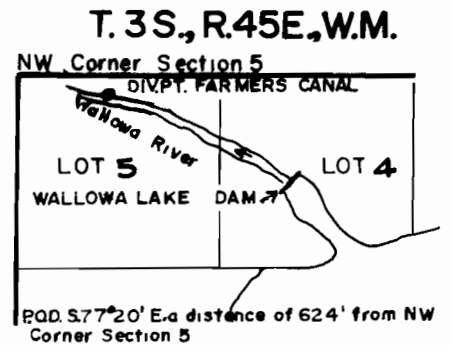


# T. 2S., R. 45E., W. M.

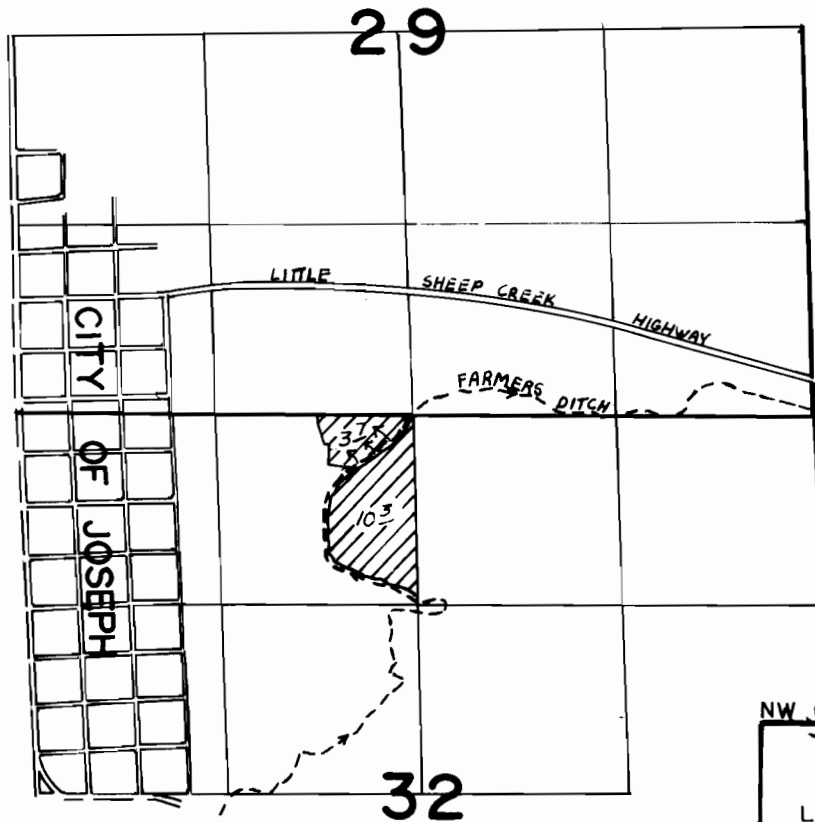

## FINAL PROOF SURVEY UNDER

Application No. 51939 Permit No. 39074.....  
IN NAME OF

RICHARD G. & CAROLE M. PATTON.

Surveyed Aug. 15..... 1985., by V. A. CHURCH.....