
90684

T. 28 S., R. 13 W., W.M.

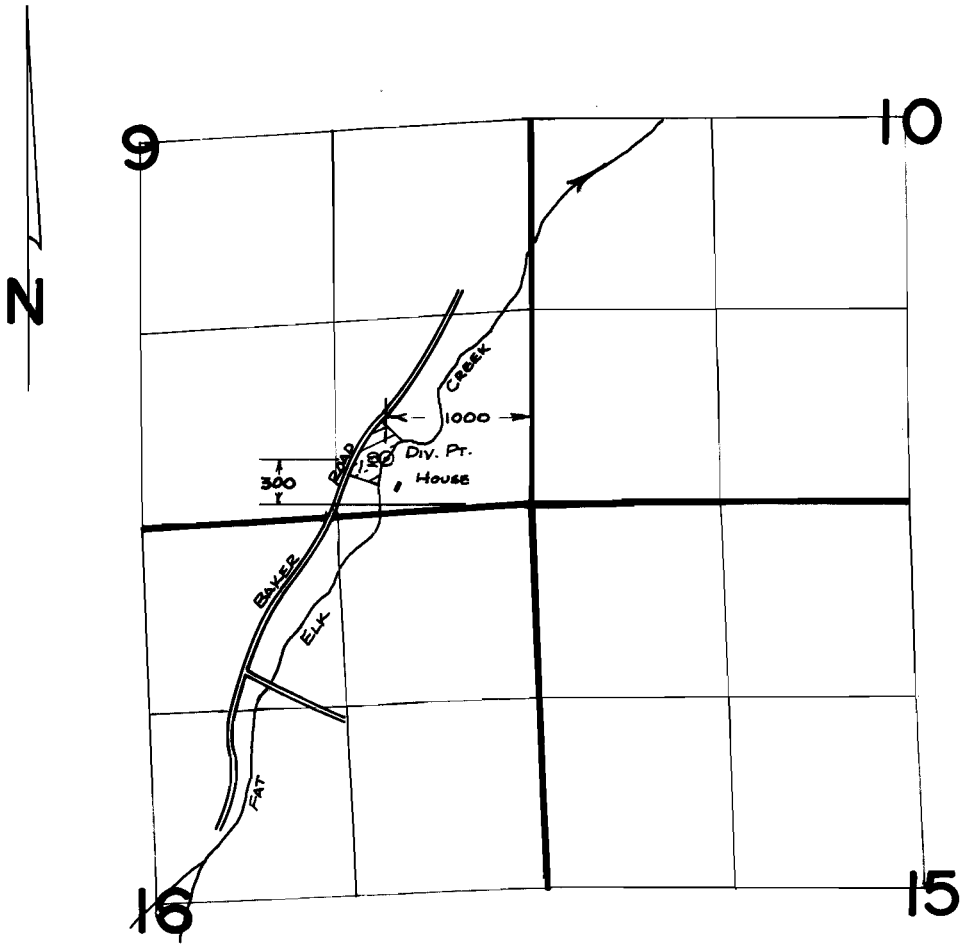

SCALE: 4" = 1 MILE

FINAL PROOF SURVEY

UNDER

Application No. 52390 Permit No. 39168

IN NAME OF

ROBERT I. & LELA JANE OERDING

Surveyed 3/21 19.88, by M. SCHMORDE