
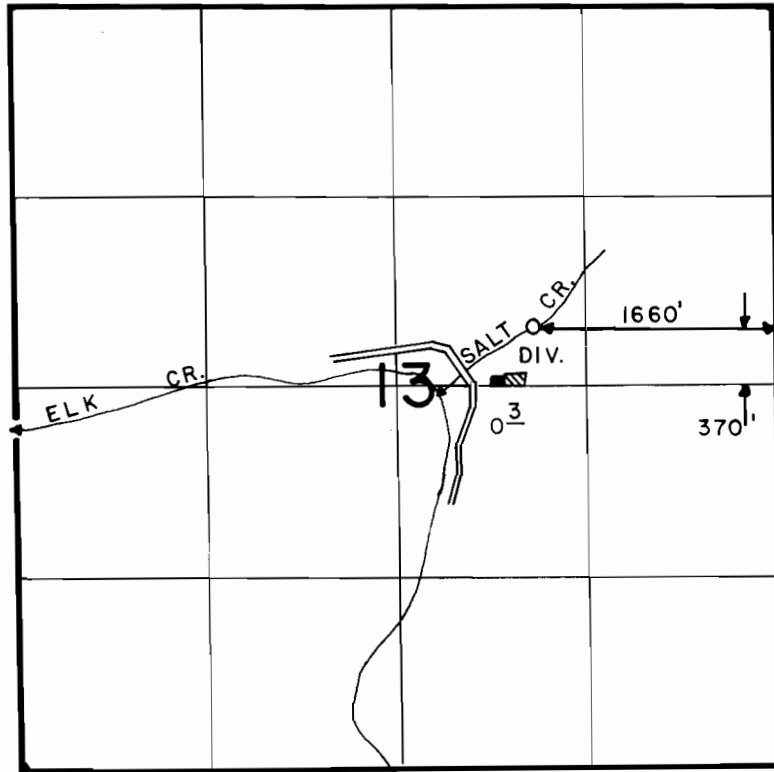


T. 22 S., R. 5 W., W. M.

SECTION 13

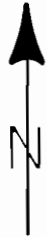

SCALE: 4" = 1 MILE

FINAL PROOF SURVEY UNDER

Application No. 52519... Permit No. 39640.....
IN NAME OF

MILTON E. LUCORE

Surveyed OCT. 20, 1986., by J. M. SCHMORDE