


T. 31 S., R. 2 W., W. M.

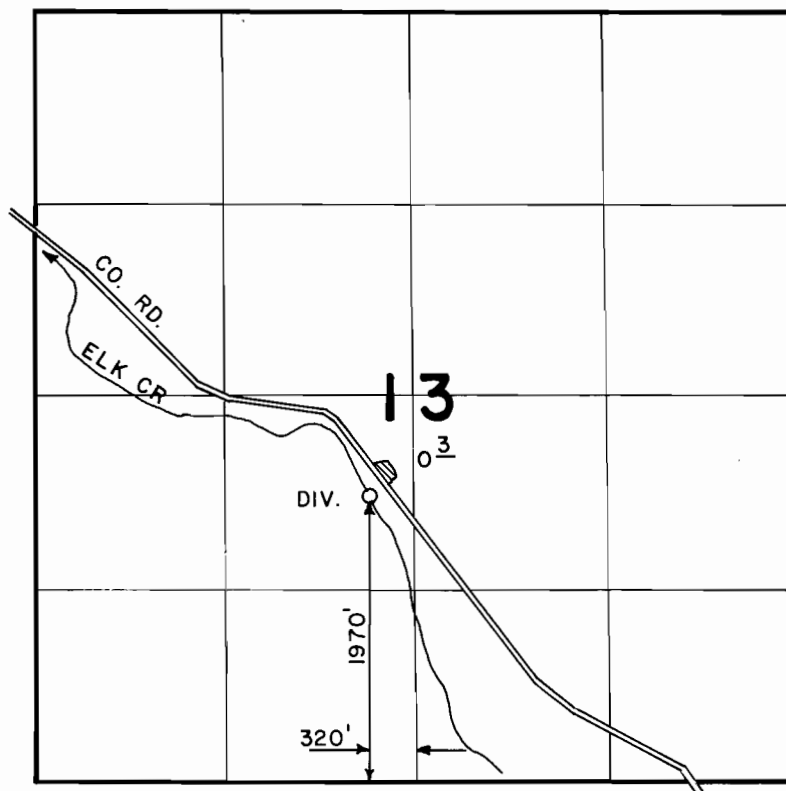

SCALE: 4" = 1 MILE

FINAL PROOF SURVEY

UNDER

Application No. 53186 Permit No. 39466
IN NAME OF

RALPH AND/OR ALVIDA STAUCH

Surveyed APRIL 6, 1988, by J. M. SCHMORDE