



T. 35 S., R. 7 W., W.M.

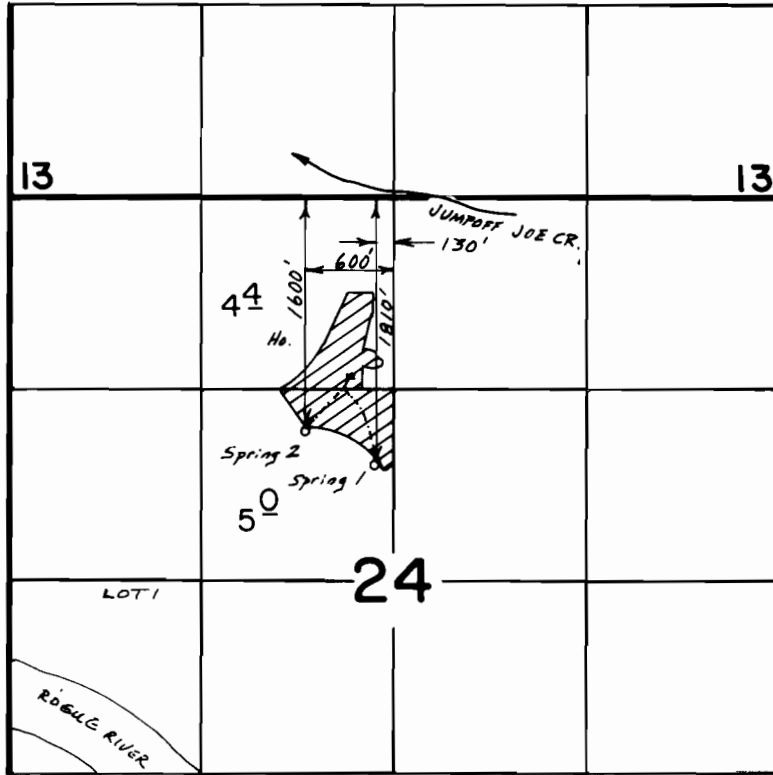

Scale 1" = 1320'

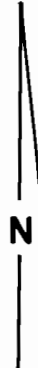

FINAL PROOF SURVEY UNDER

Application No. 53754. Permit No. 40368.....
IN NAME OF

.....THEODORE.....E.....STIEWIG.....

Surveyed Oct. 27, 1987, by B.S. JAMES.....