
90684

T. 28 S., R. 13 W., W.M.

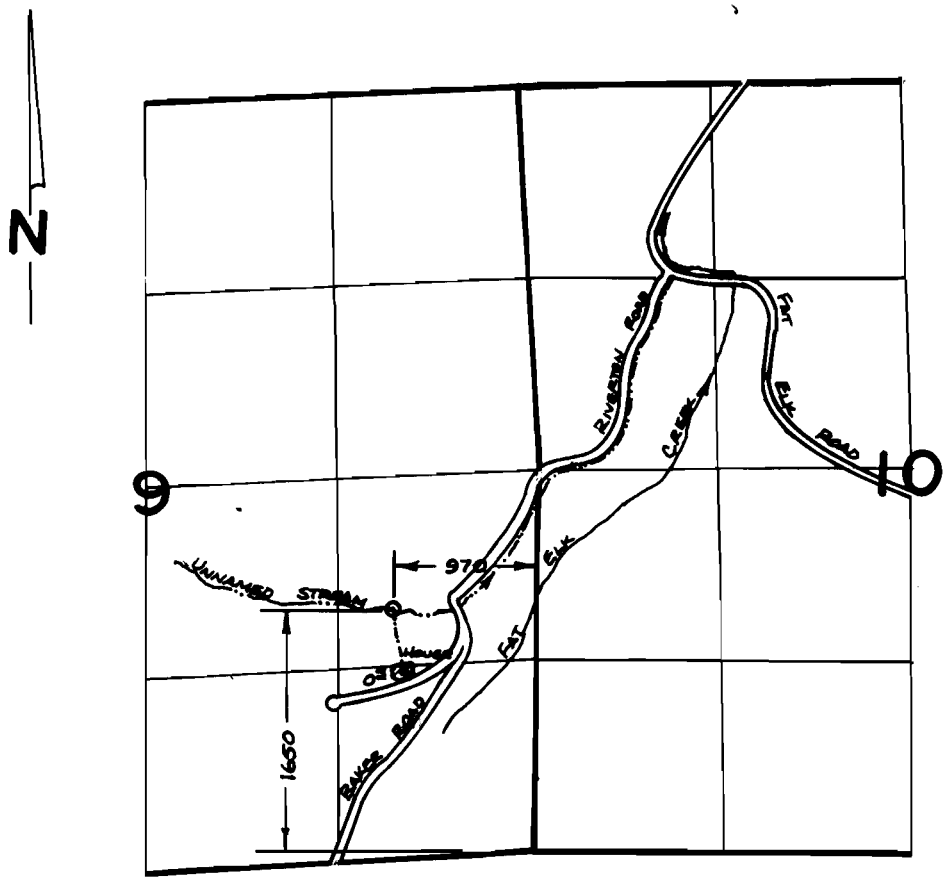

SCALE: 4" = 1 MILE

FINAL PROOF SURVEY

UNDER

Application No. 54271 Permit No. 40641

IN NAME OF

ALVIN A. &/OR MARJORIE L. CLAFLIN

Surveyed 3/16 19.88, by M. SCHMORDE

4011-180-197C MS