


T. 40 S., R. 14 W., W. M.

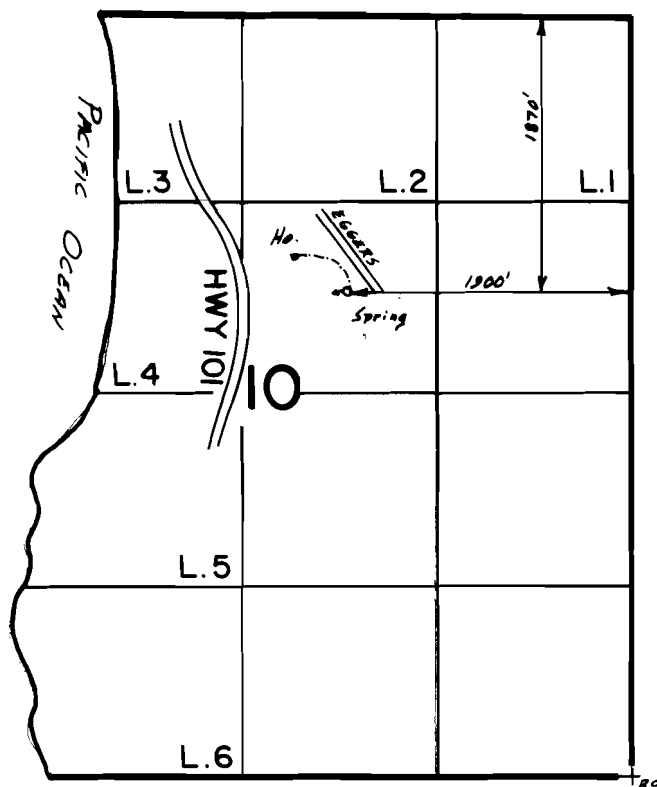

Scale 1" = 1320'

FINAL PROOF SURVEY UNDER

Application No. 54507 Permit No. 40881.....
IN NAME OF

LENTHAL L. & or HELEN E. BENNETT

Surveyed Sept. 2., 1987, by J.M. SCHMORDE