


T. 30 S., R. 12 W., W.M.

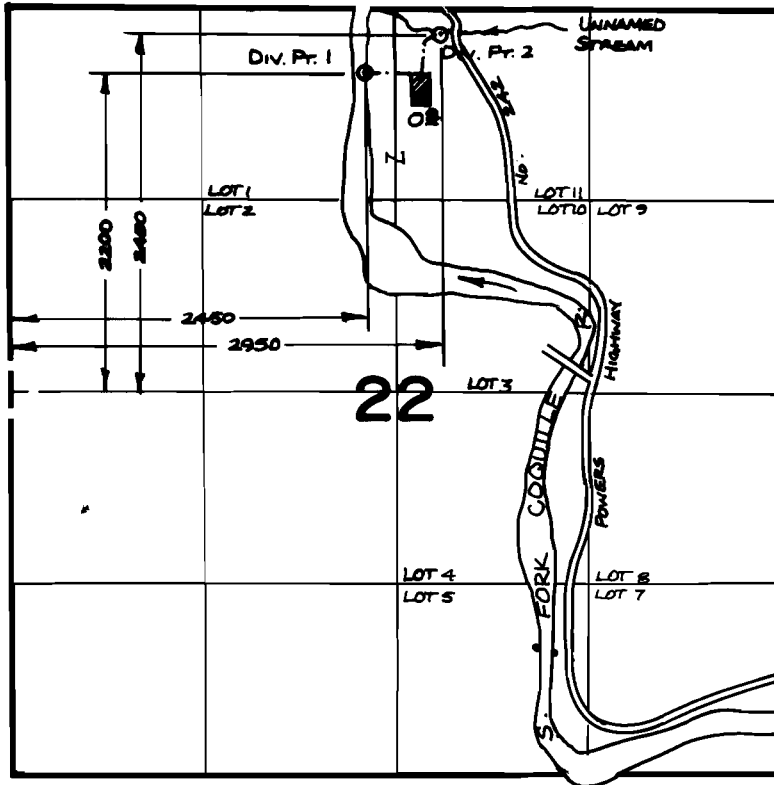

SCALE = 4" = 1 MILE

FINAL PROOF SURVEY UNDER

Application No. .54516.. Permit No.40885...
IN NAME OF

.....GENEVIEVE..M..ELLIOTT.....

Surveyed ...7/20.... 19.88, by ..M..SCHMORDE....